


S. 1/4 Cor Sec 36, T. 15, R. 3 E.

POWELL VALLEY - DAMASCUS ROAD NO. 181 (40')



Center Sec 36

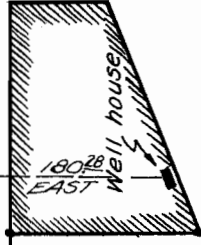

S. W. 1/4 of the S. E. 1/4 Sec 36

N. W. 1/4 of the S. E. 1/4 Sec 36

G-3807
G-3592

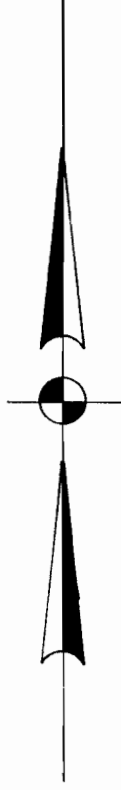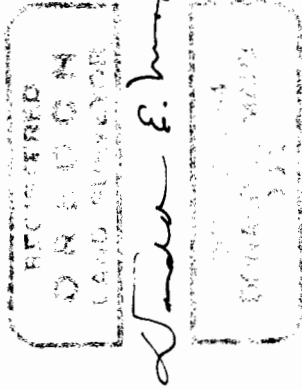

WELL LOCATION for PACIFIC FUR FOODS, INC.
A PORTION OF TR. 11 "COOLRIDGE HOME TRACTS"
IN the NW 1/4 of the S.E. 1/4 Sec. 36, T. 15, R. 3E. W.M.

SCALE: 1" = 200' APPROVED BY
DATE: 4-26-67 DRAWN BY A.C.S.

CLACKAMAS COUNTY OREGON

By: MARX & CHASE, Surveyors Inc.
Gresham, Oregon

DRAWING NUMBER
67-179