


G-3607 15

T.40S.,R.8W.,W.M.

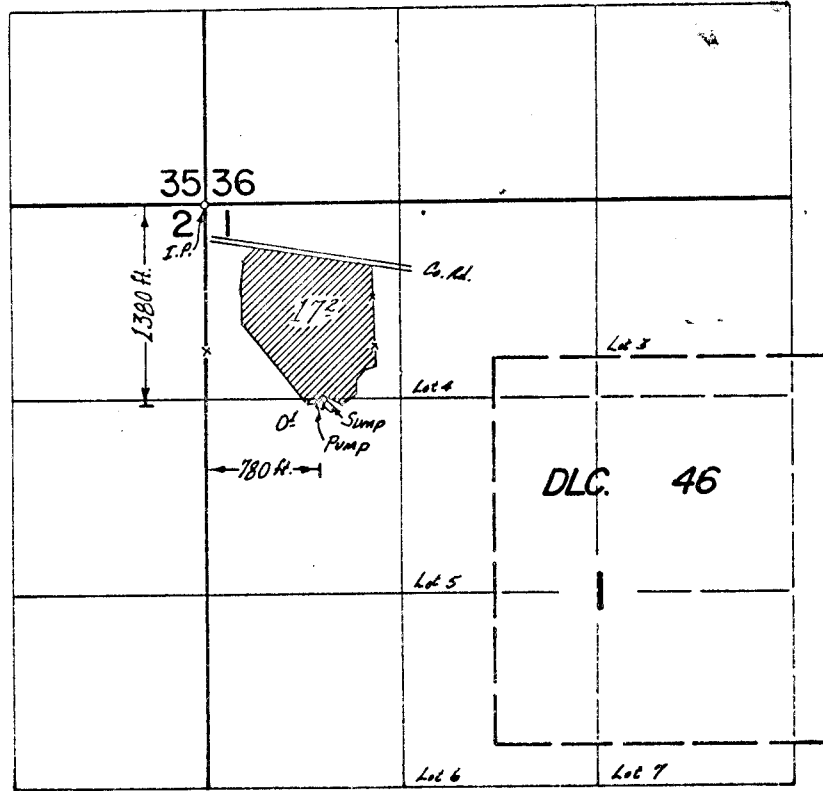

FINAL PROOF SURVEY
 UNDER

Application No. G-3827 Permit No. G-3607
 IN NAME OF

RAY L. JAMES

Surveyed 30 Oct 1972, by L.F. GOULD

C-37672

1972-U *Sec*