


LOG SPRINKLING WELL  
 ELGIN LOG YARD  
 ELGIN, OREGON.

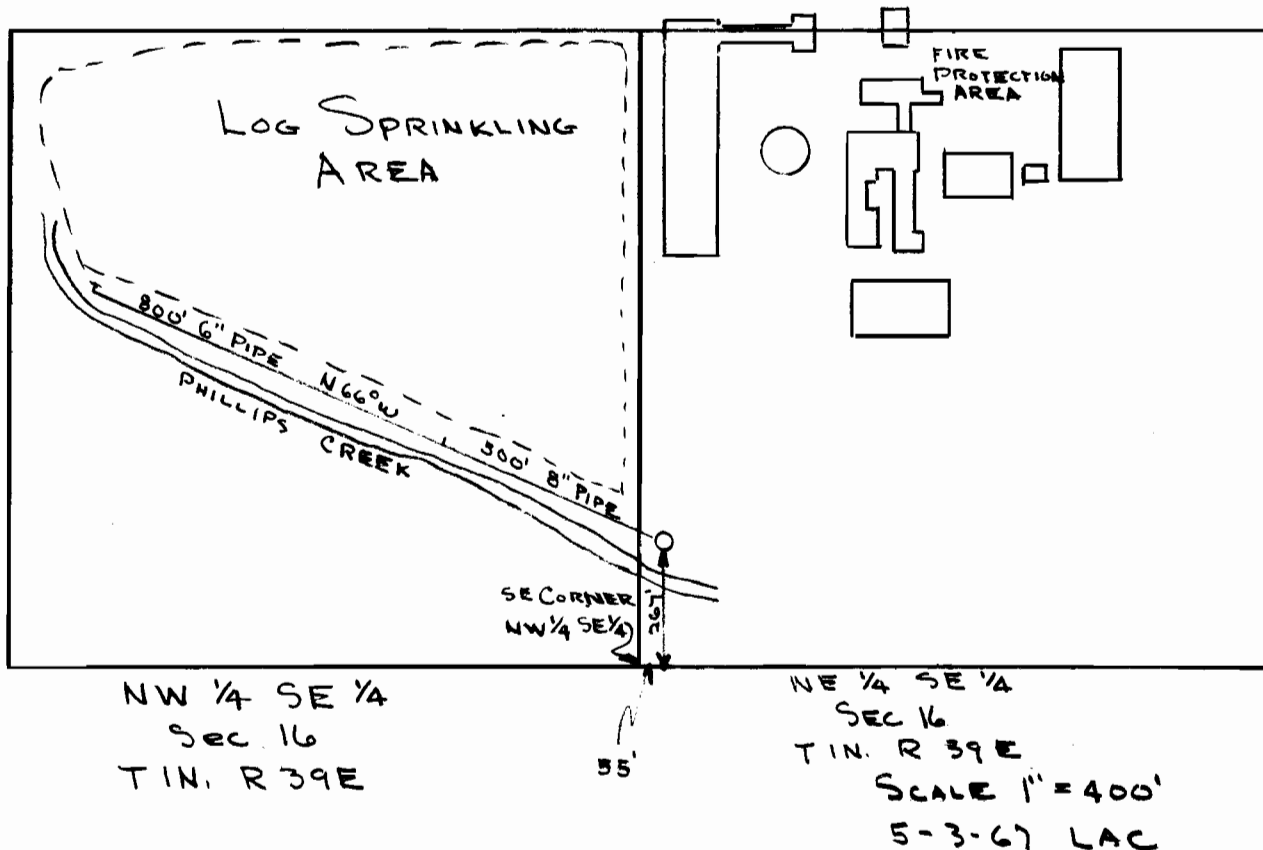

G-3832  
 G-3612

**RECEIVED**  
 JUN 20 1967  
 STATE ENGINEER  
 OREGON

Application No. G-3832