


T.4S.R.IE.W.M.

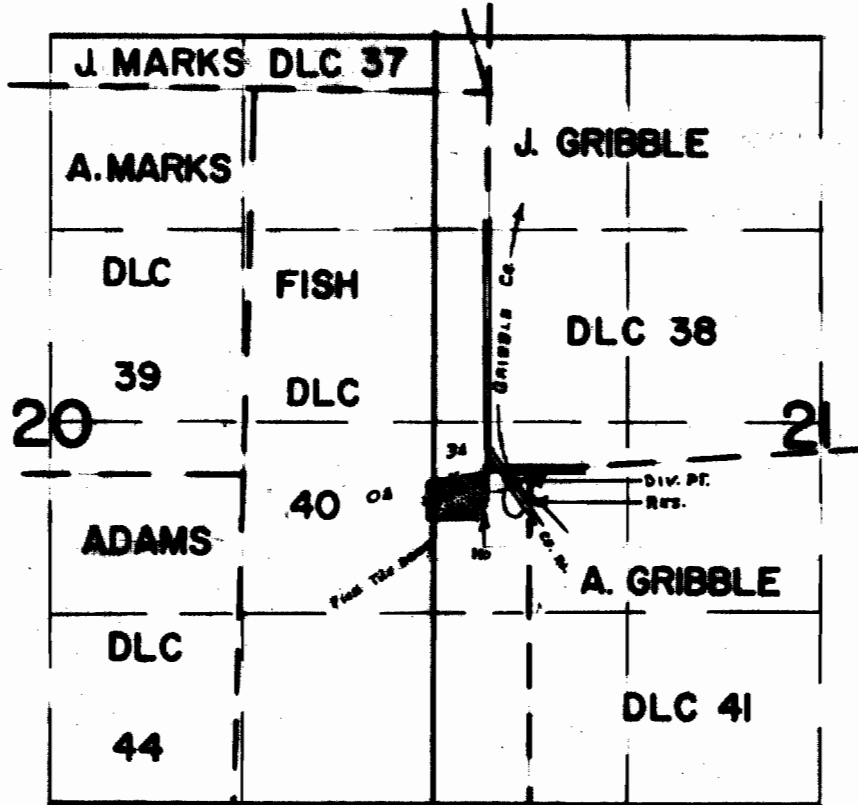

DN PTS. LOC: CR-70'S. & 190'E., RES. DRAM-130'S. & 170'E.; BOTH FROM SW COR. J. GRIBBLE DLC 38

FINAL PROOF SURVEY UNDER

G-3870
R-43435

G-3643
R-4987

Application No. ~~43436~~ Permit No. ~~32474~~
IN NAME OF

JOHN H. PETERS

Surveyed APR. 28, 1971., by R. MUCKEN.....