


G-3697

1969-1

# T. 37 S. R. 5 W. W.M.

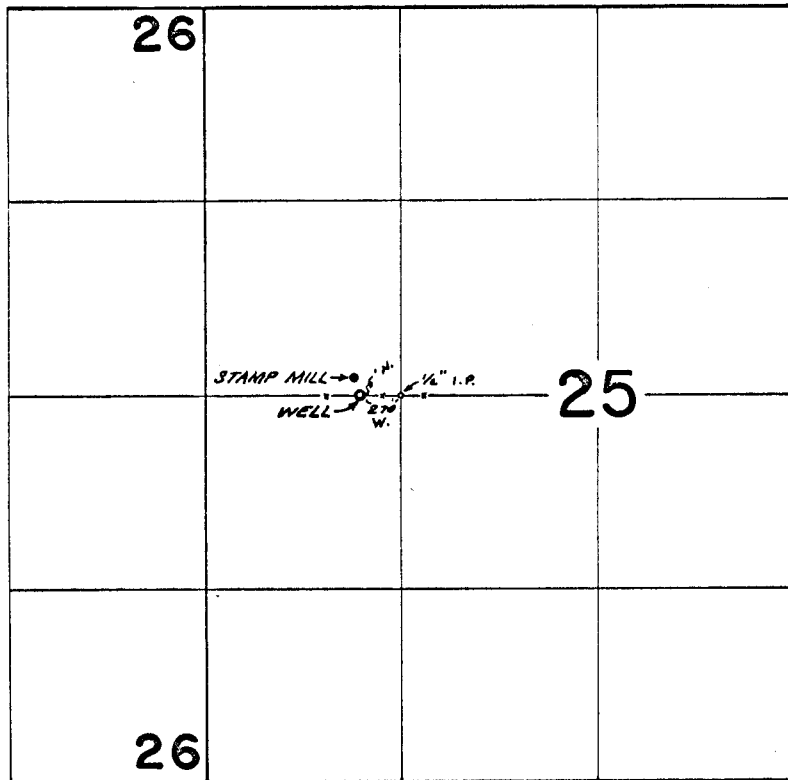

## FINAL PROOF SURVEY UNDER

Application No. G-3940 Permit No. G-3697  
IN NAME OF

THOMAS C. SCHULTZ

Surveyed JUN 3 1969, by D. BUELL