




# T.3N.R.34E.W.M.

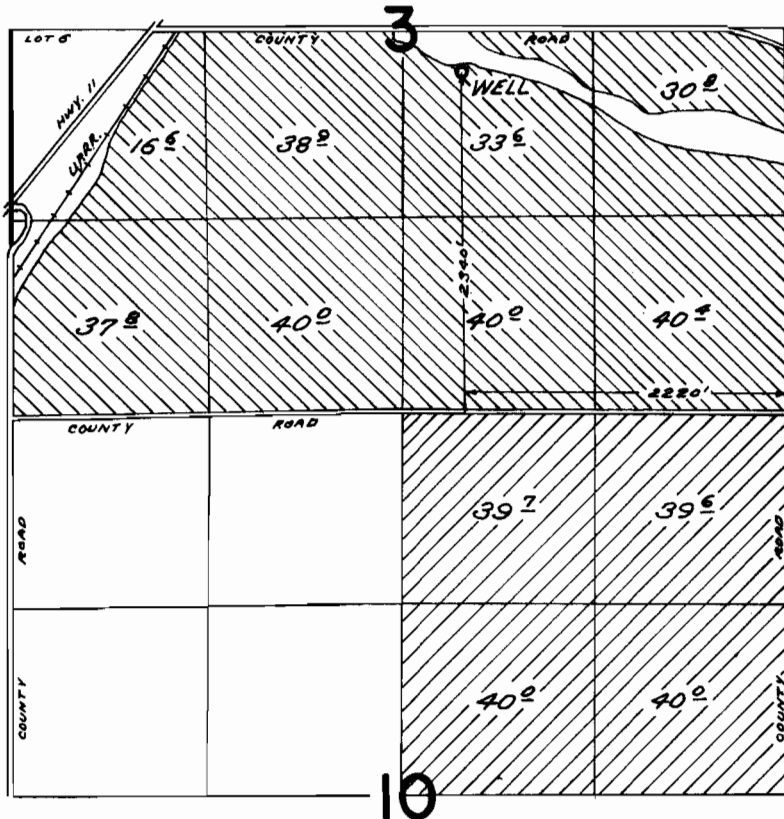

 PER. G-2798
  PER. G-3770

## FINAL PROOF SURVEY UNDER

Application No. G-3003 Permit No. G-2798  
G-4020 G-3770  
 IN NAME OF

LIEUALLEN RANCH, INC.

Surveyed APR. 18 1973, by D.M. NORBY

40374