


T.6S. R.2W. W.M.

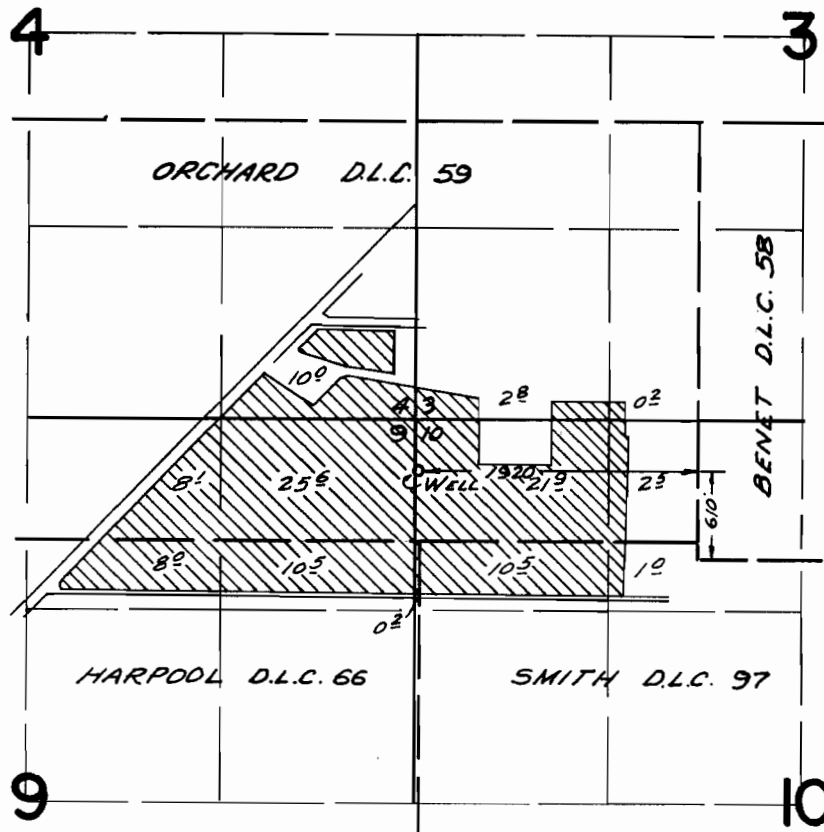

FINAL PROOF SURVEY UNDER

Application No. *G-4021* Permit No. *G-3771*
IN NAME OF

RALPH E. LEBER

Surveyed *June 20 19.68*, by *V. Garner*