

PREPARED BY: *M. F. V.P.*

PAGE NO. *1* OF *6*


CHECKED BY:

REPORT NO.

DATE: *MARCH 25, 1968*

SCALE: 4 in. = 1 MILE

RECEIVED
MARCH 29 1968
STATE ENGINEER
SALEM, OREGON

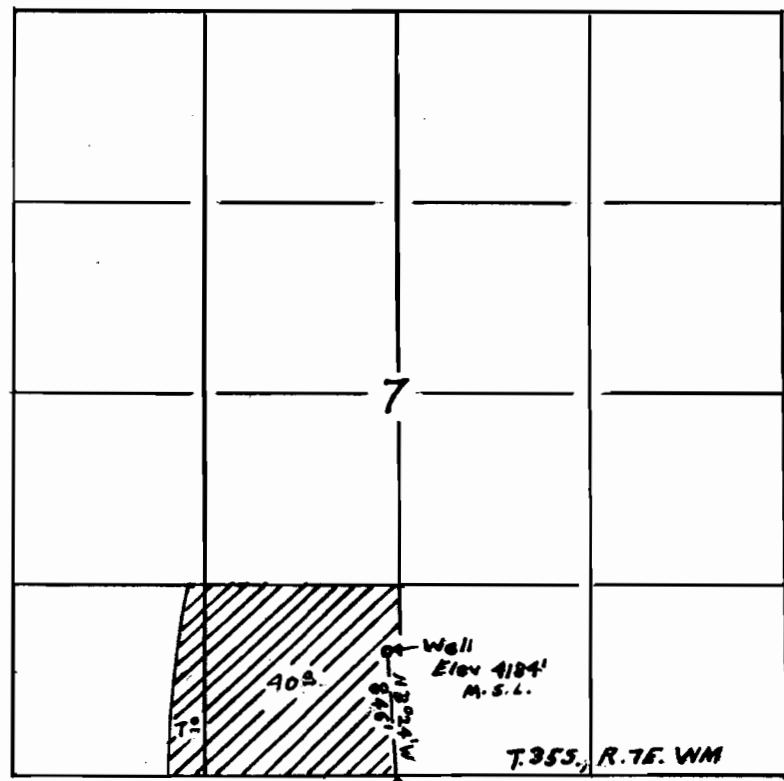

Application No. *G-4233*
Permit No. *G-3865*

LATAKOMIE SHORES - WELL No. 1 DETAILS

FORM M 152-R-2 NEW 6-62