


IN SEC. 11 T35 R1W WMT

Scale 1" = 1000'

OREGON



RECEIVED
MAY 17 1960
WASHINGTON COUNTY
CLACKAMAS COUNTY

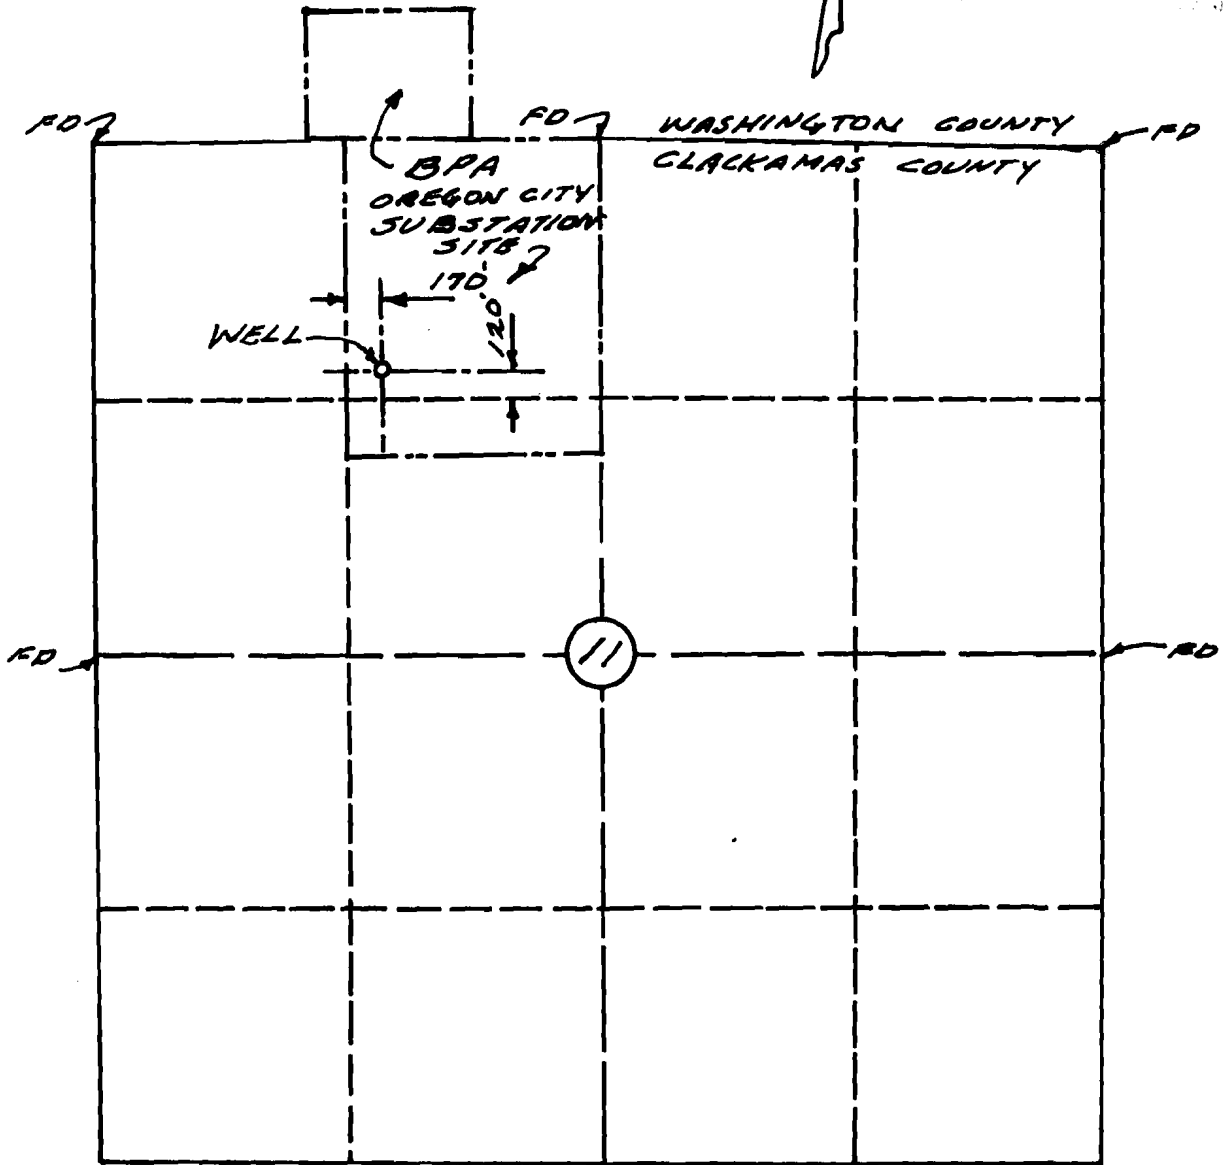

G-4184
G-3933