

3127

3028

30295

3129


3228

3128



LOCATION OF WATER USING EQUIPMENT

LOCATION - COOLING WATER WELL
 PORTLAND STATE COLLEGE 2-9-68.

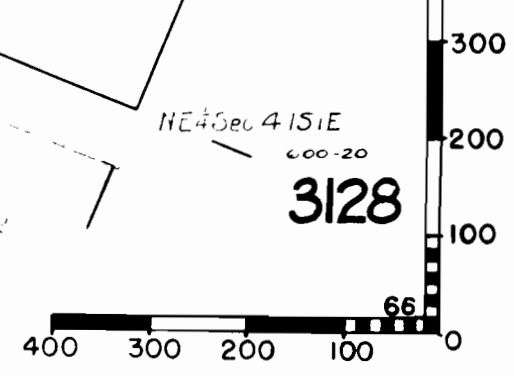

NE 4 Sec 4 151 E
 6-00-20