


Section 14 Twp 23 S, Rg 30 E W.M.
HARNEY COUNTY OREGON

SCALE 5" to 1 mile

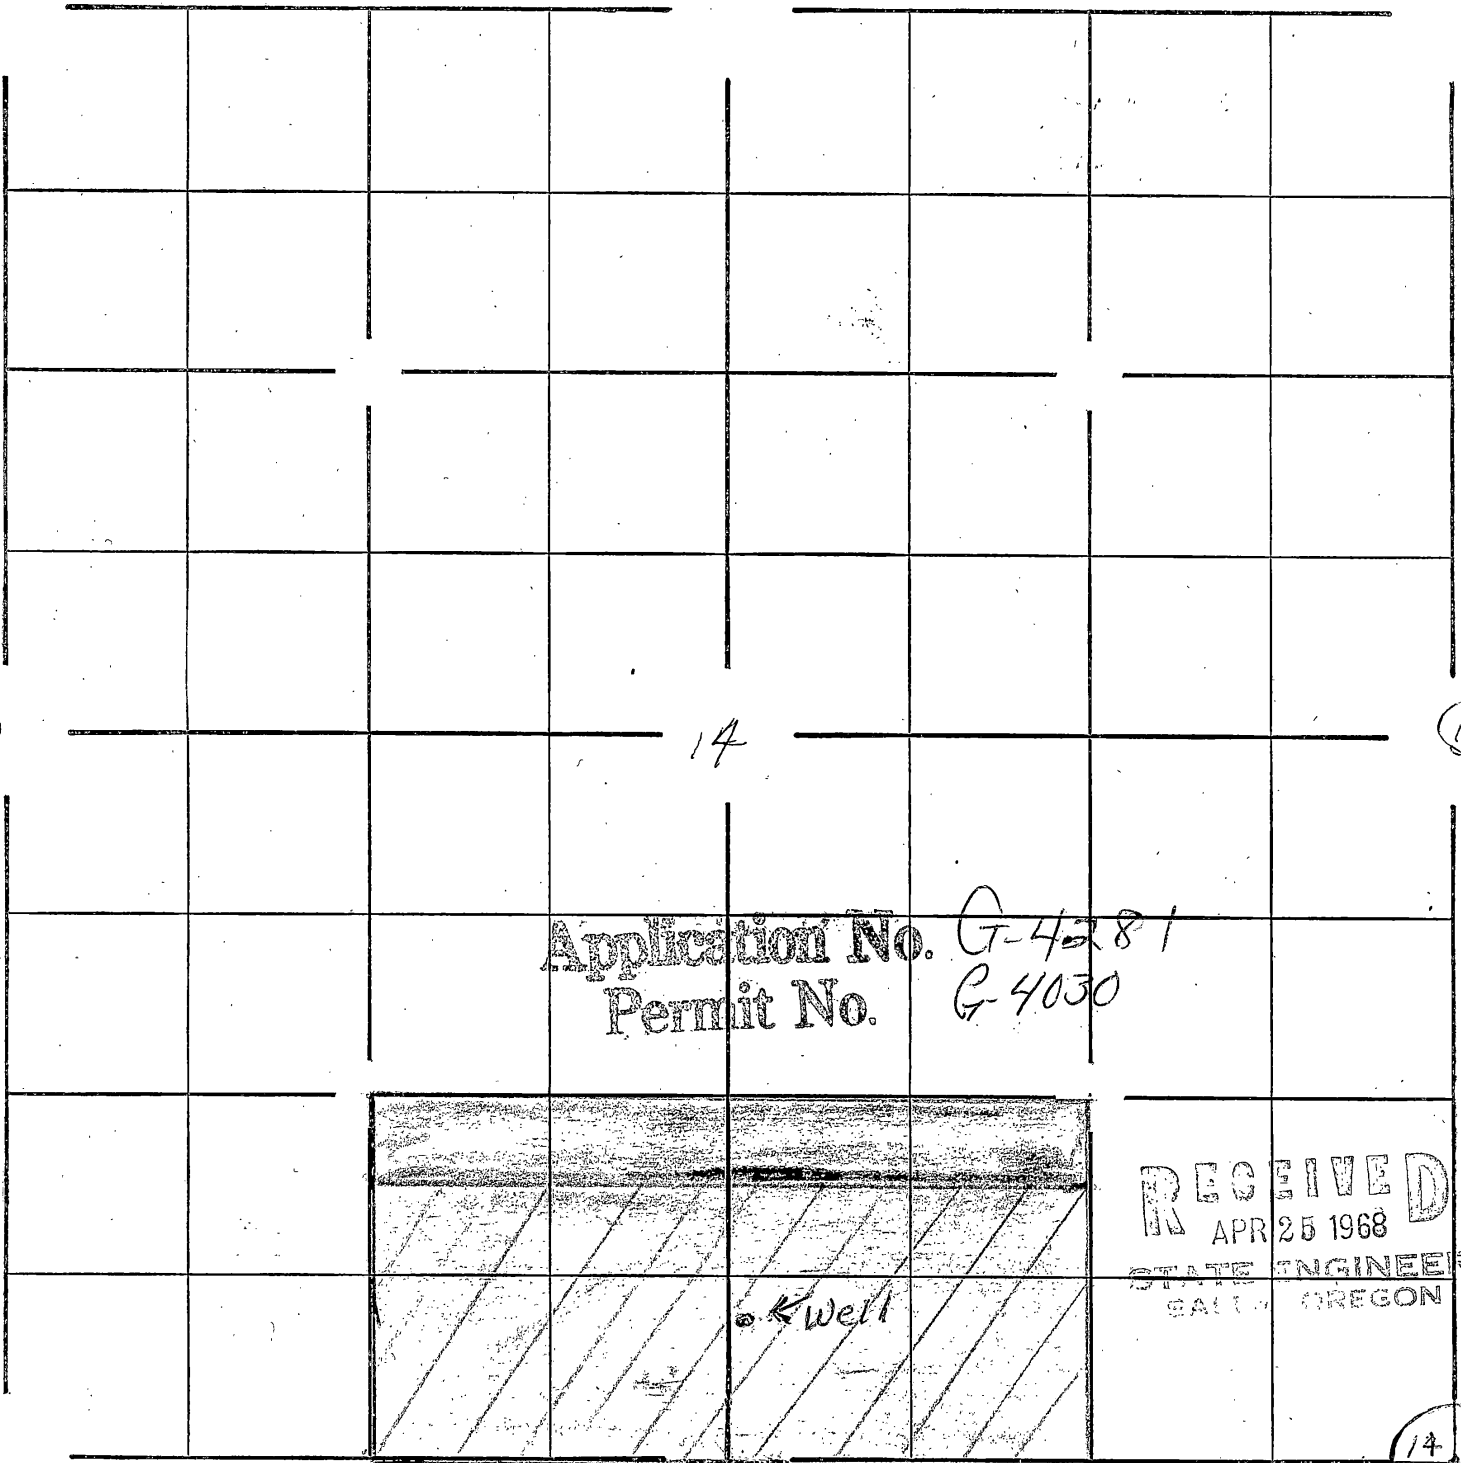

Blue - 60 Acres to be SPRINKLE IRRIGATED,
 Red - 20 Acres not to be irrigated
 TOTAL 80 Acres OWN. (5)

14 13
23 24