


RECEIVED  
MAY 8 1968  
STATE ENGINEER  
SALEM

T 38 S., R 4 W., W. M.

RECEIVED  
MAY 8 1968  
STATE ENGINEER  
SALEM

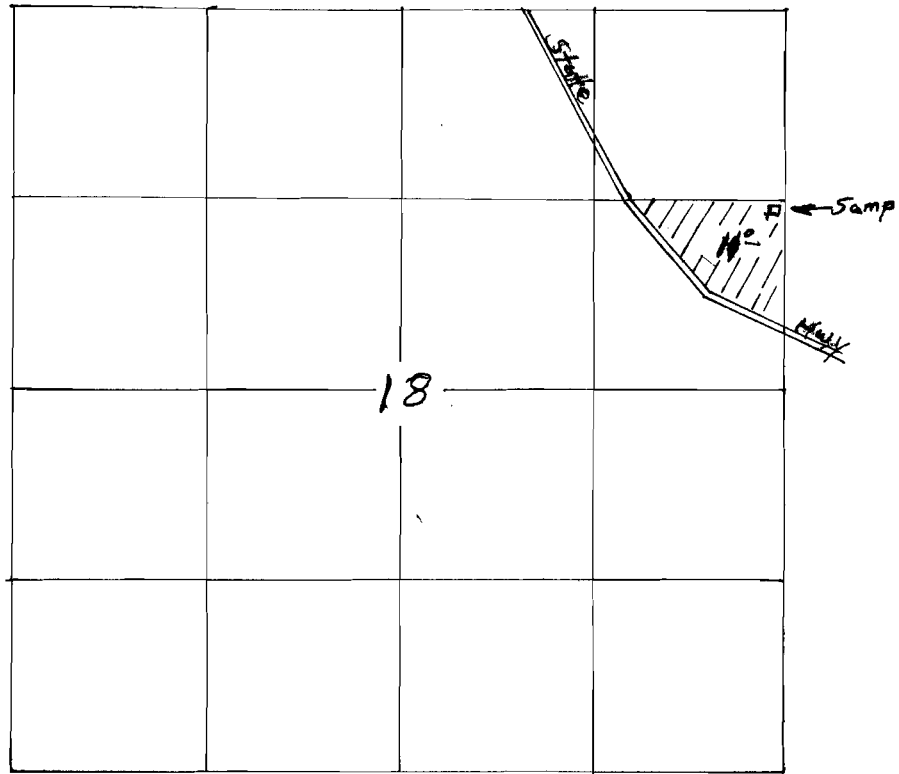

Scale: 4" = 1 mile

Sump located 1340' S + 20' W. from  
NE Cor Sec 18

G-4295  
G-4143

Ashton Foerst  
6-5-68