


T.36S.R.6W.W.M.

RECEIVED

DEC 13 1974

WM. DIST. 14
GRANTS PASS, ORE

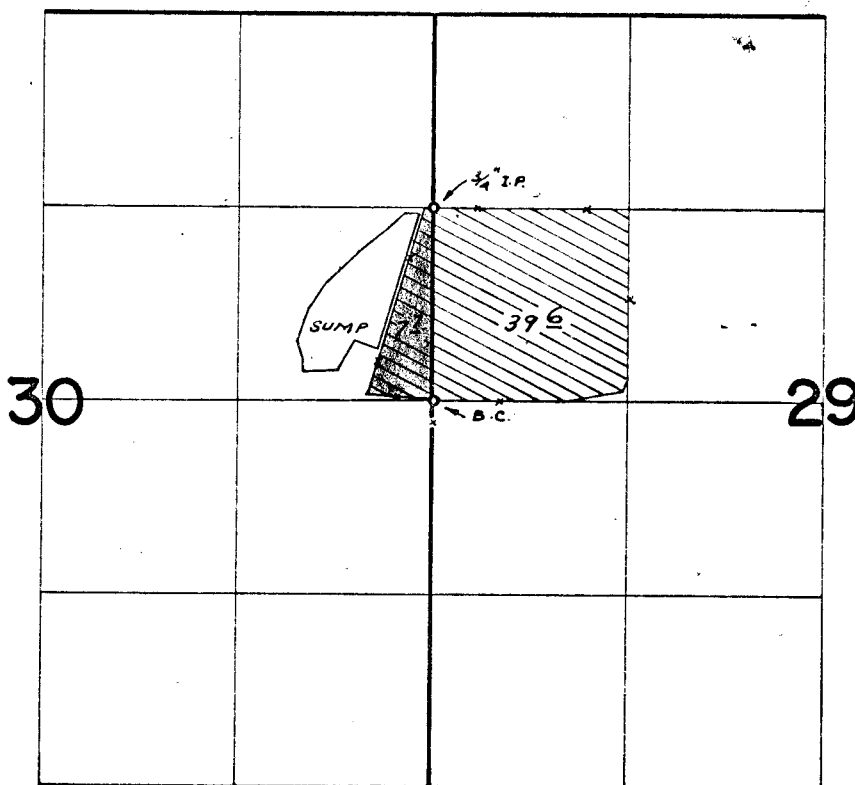

SUMP LOC: 700' N. & 500' W. FROM E 1/4 COR. SEC. 30

Not applied for in Application

Not granted under Certificate # 39870

FINAL PROOF SURVEY
UNDER

Application No. G-4359 Permit No. G-4113
IN NAME OF

THOMAS R. HART

Surveyed APR. 20 1972, by R. MUCKEN