


G-4122

T.36S.R.6W.W.M.

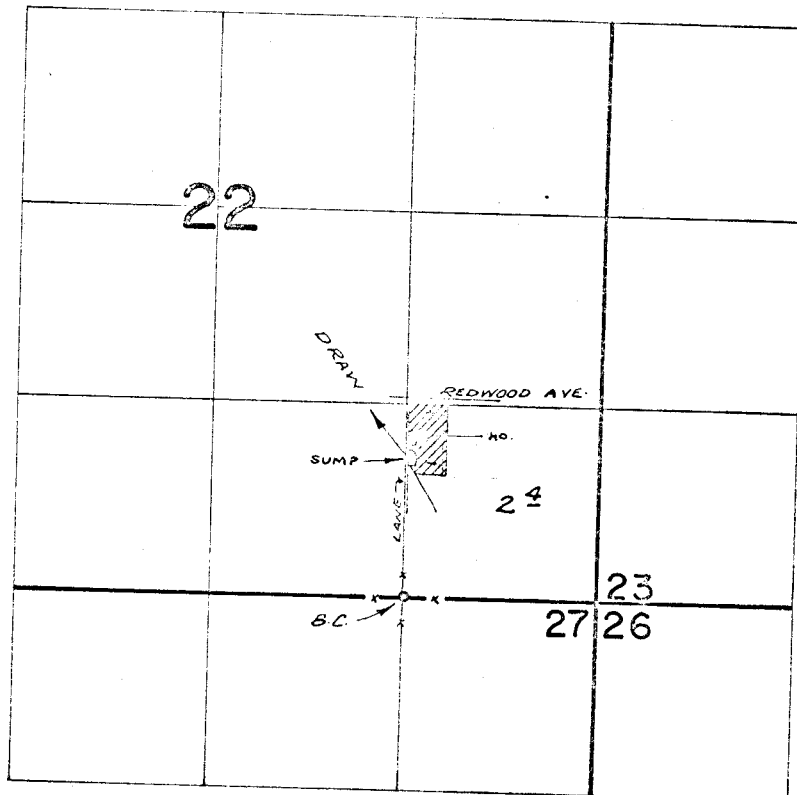

FINAL PROOF SURVEY
UNDER

Application No. G-4370 Permit No. G-4122
IN NAME OF

JOSEPH R. RITSCH

Surveyed APR 20, 1972, by R. MUCKEN