

RECEIVED

JAN 13 1968

STATE ENGINEER
SALEM OREGON

TIN, R 4 W, W M

RECEIVED


OCT 28 1968

STATE ENGINEER
SALEM OREGON

RECEIVED

NOV 6 1968

STATE ENGINEER
SALEM OREGON

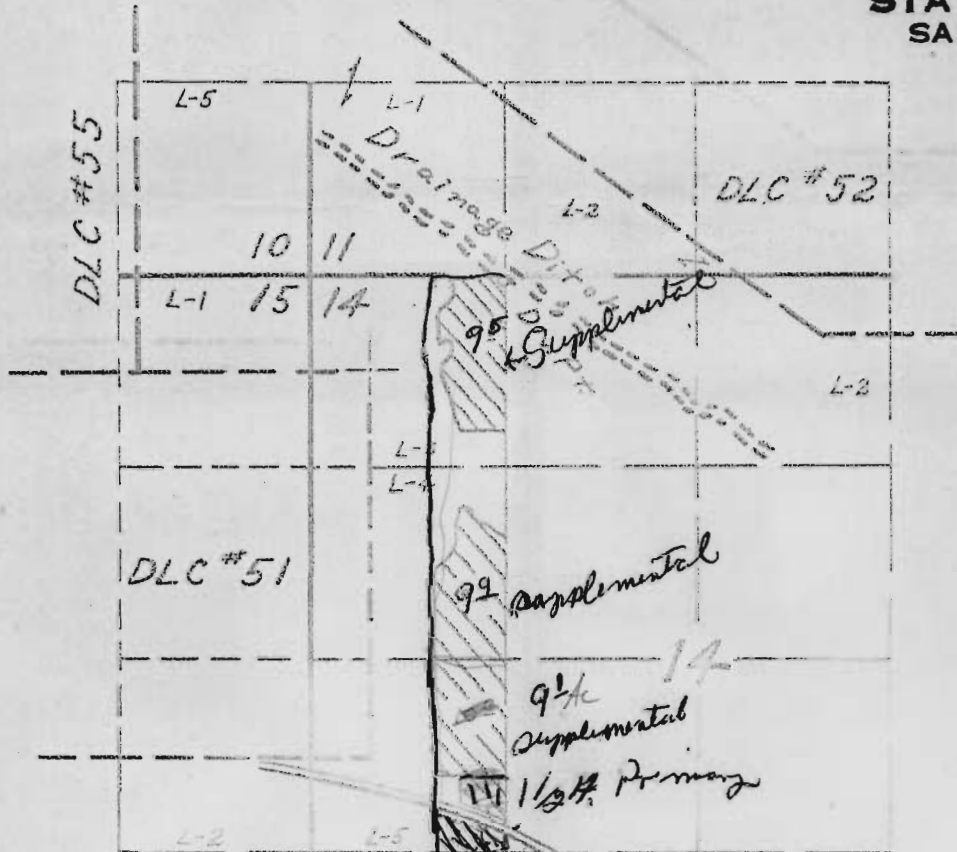

Application No. G-4535
Permit No.

FINAL PROOF SURVEY
UNDER

Application No. 25509 Permit No. 20040
IN NAME OF

Walter S. Willis

Surveyed 4-13 1956 by R.D. Rest