


G-4303

15

T.35S.R.6W.W.M.

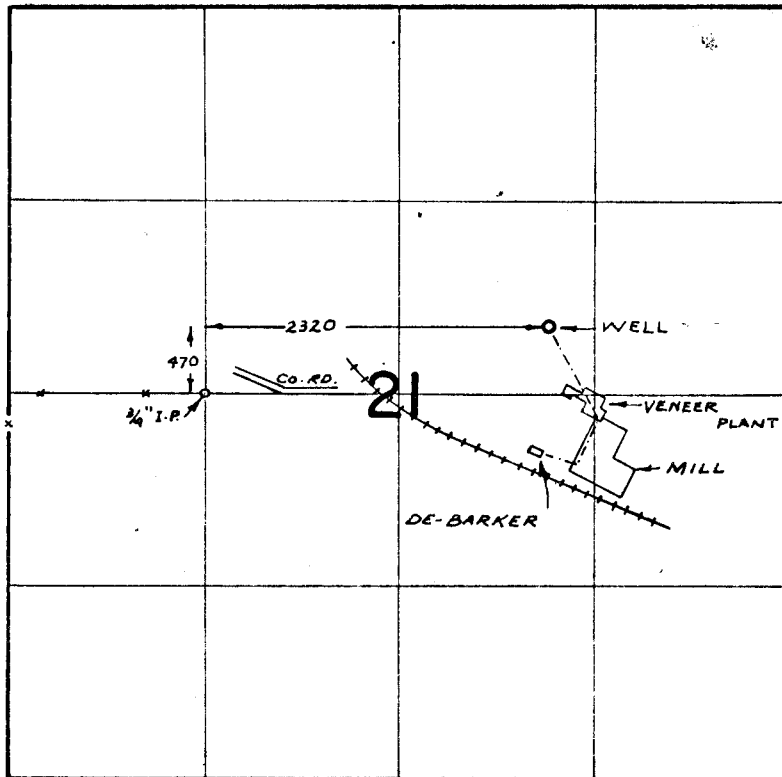

FINAL PROOF SURVEY
UNDER

Application No. G-4432 Permit No. G-4303
IN NAME OF

BATE PLYWOOD CO., INC.

Surveyed APR. 14, 1972. by R. MUCKEN

C-211, 7-5

1972-U