


Scale 4" = 1 Mile

T 3 S., R 28 E.

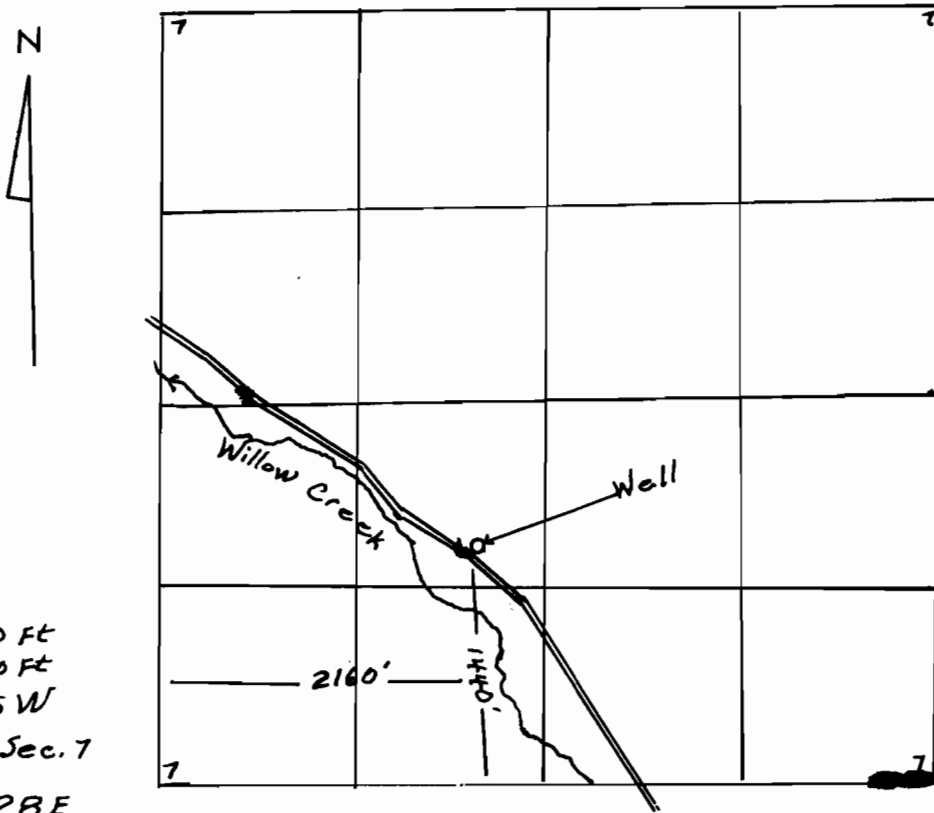

Well is 1440 FT  
North + 2160 FT  
East from SW  
corner of Sec. 7  
T 3 S., R 28 E.

Application No. G-4609  
Permit No. G-4333

**RECEIVED**  
SEP 20 1968  
STATE ENGINEER  
