


T. 24 S., R. 5 W. W.M.
SCALE: 1"=200'

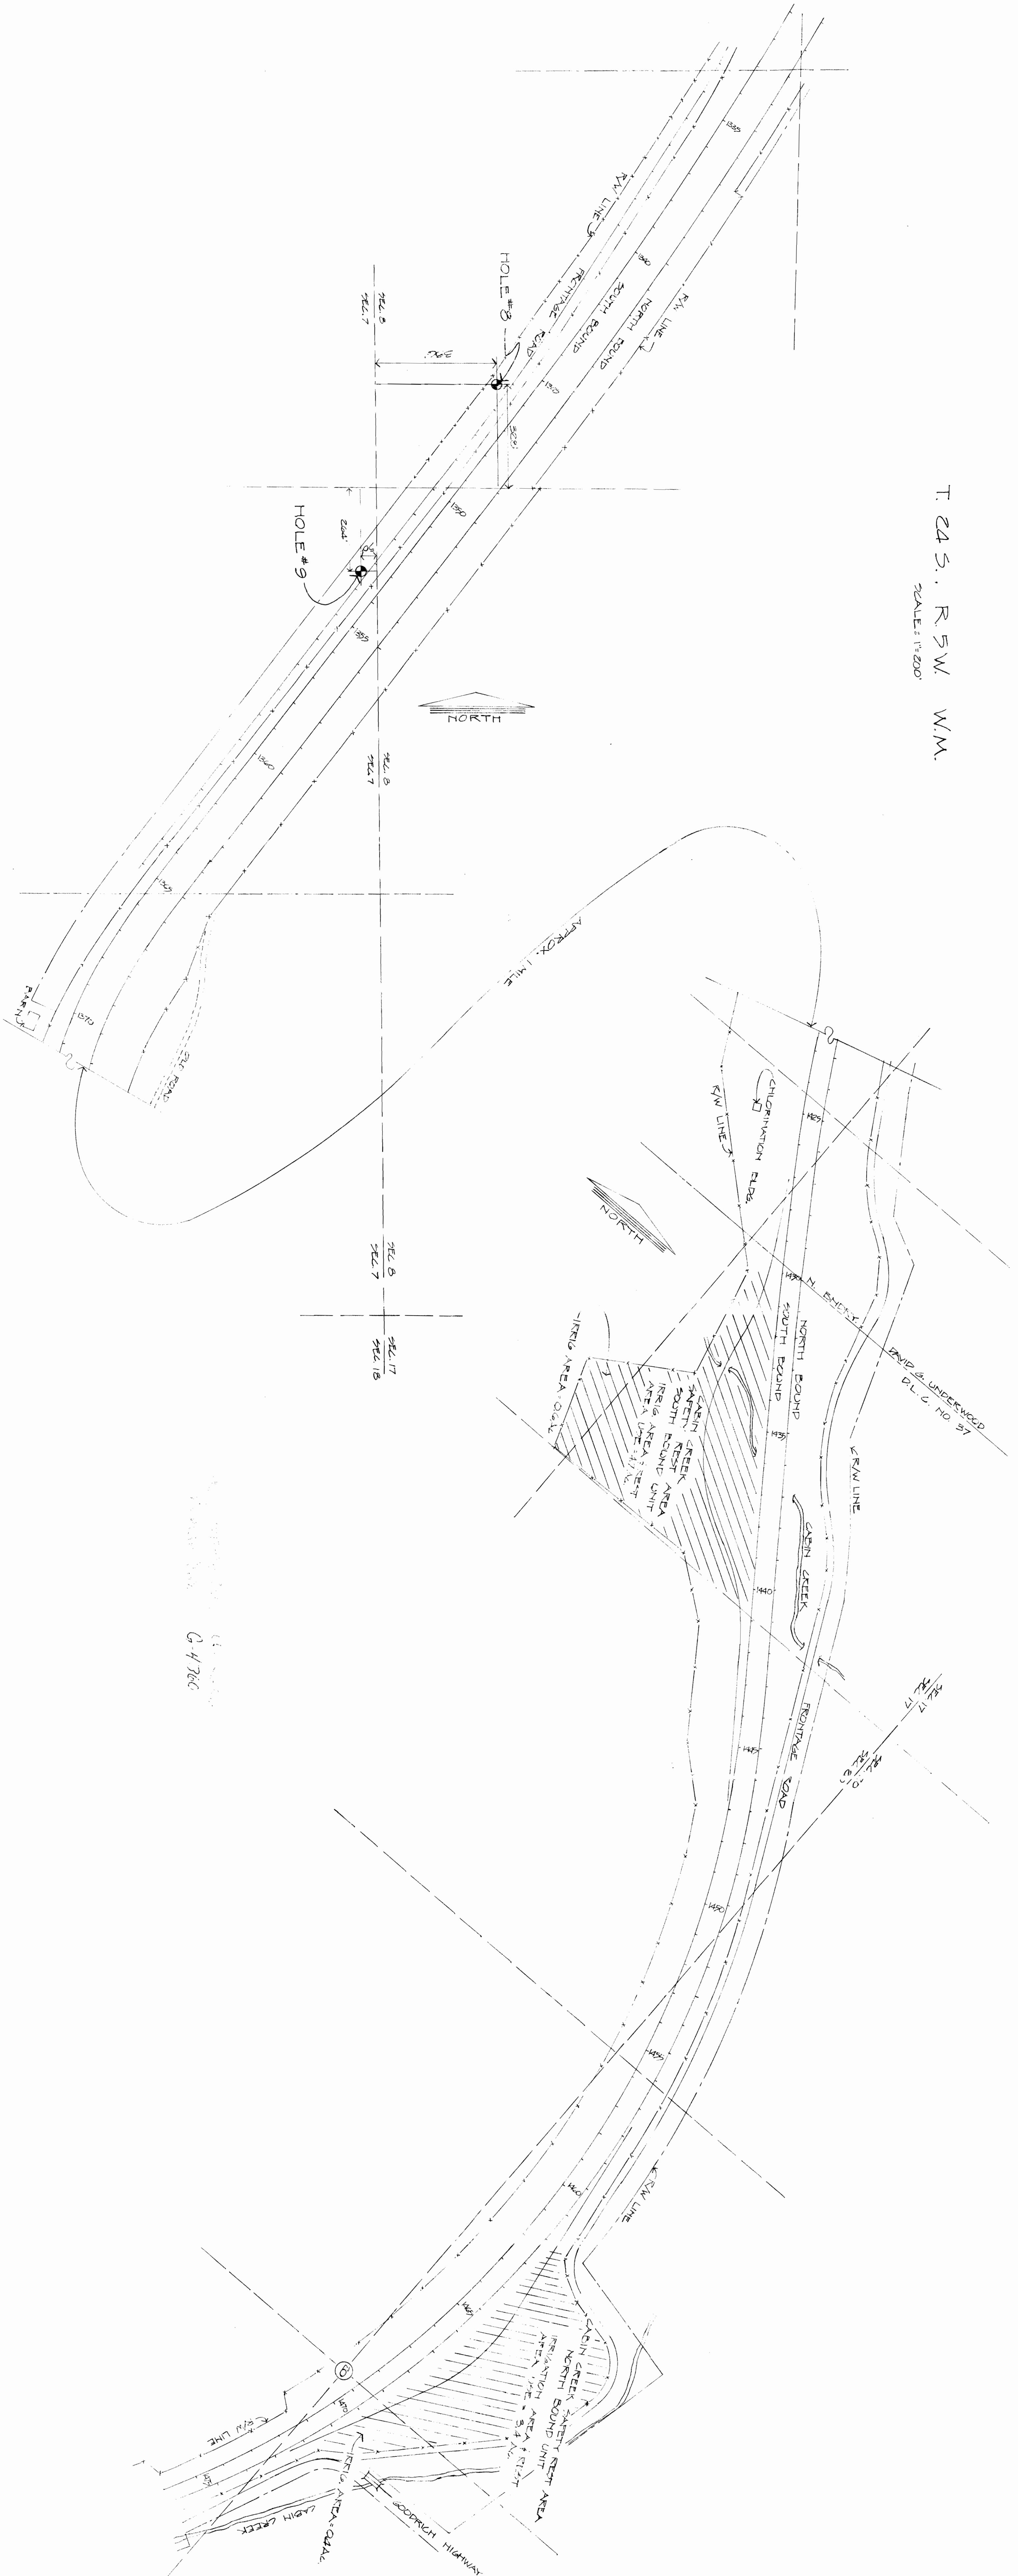

