


T.26S.R.31E.W.M.
SOUTH OF MALHEUR LAKE

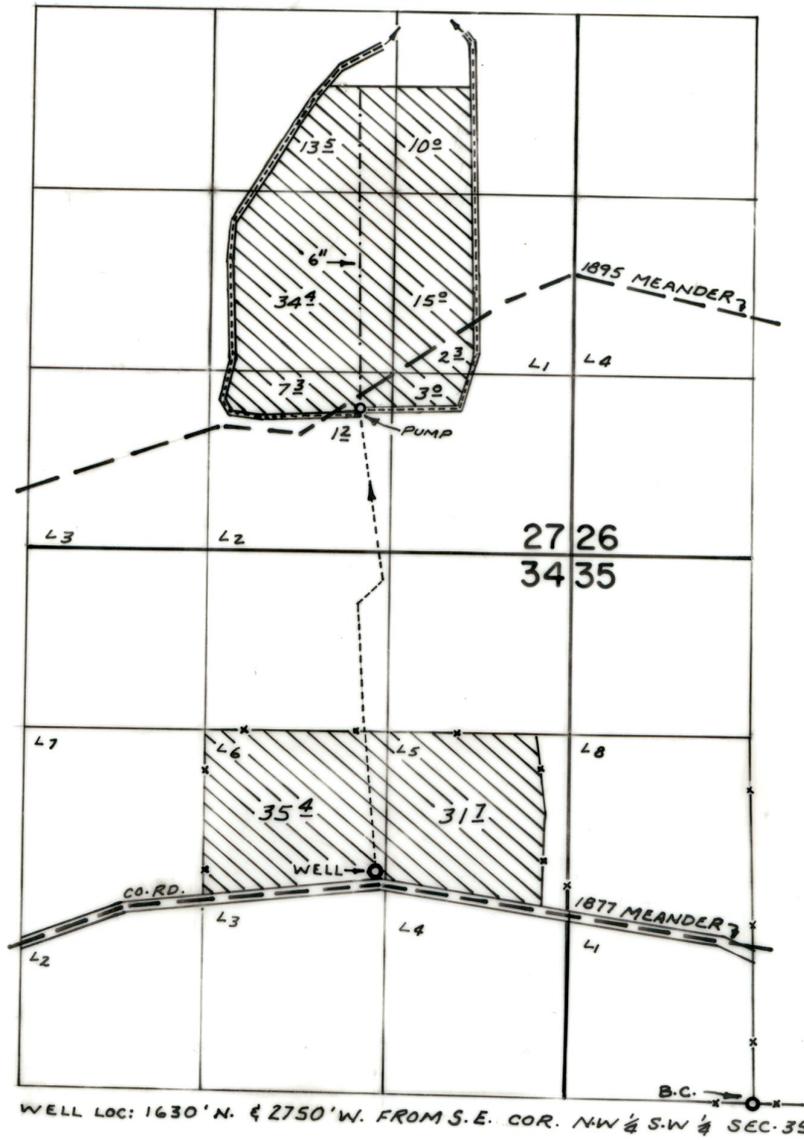

FINAL PROOF SURVEY
UNDER

Application No. G-4650 Permit No. G-4374
IN NAME OF

WALTER T. MCEWEN

Surveyed JUNE 24, 1976, by R. MUCKEN