

G-4414


37-5-57

T.37S.,R.5W.,W.M.

RECEIVED

NOV 24 1976

WM. DIST. 14
GRANTS PASS. ORE.

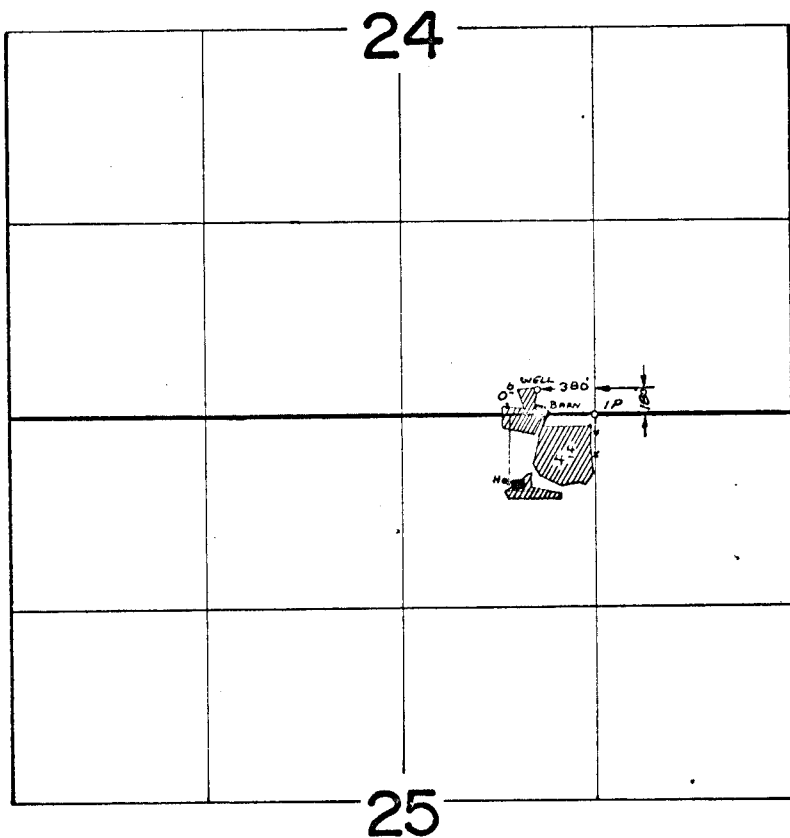

FINAL PROOF SURVEY
UNDER

Application No. G-4695. Permit No. G-4414.
IN NAME OF

WILLIAM FINDLEY

Surveyed Oct. 7 1974, by L. T. Holt