


G-4462

T.38S.,R.5W.,W.M.

RECEIVED  
NOV 24 1976

WM. DIST. 14  
GRANTS PASS. ORE

38-5-31

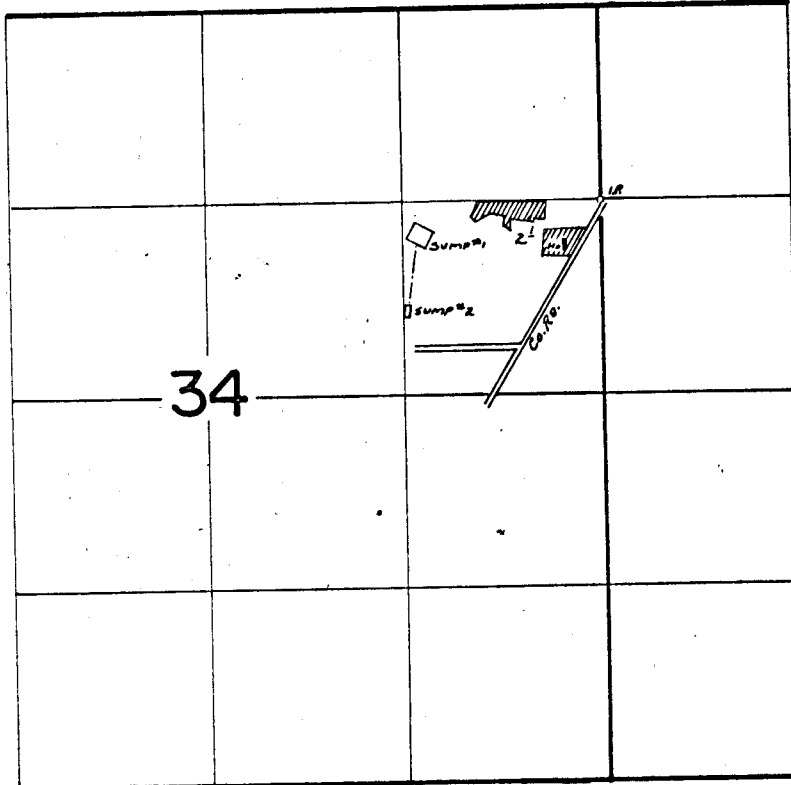

SUMP #1 : 200'S AND 1200' W } FROM SE COR OR NE 1/4 NE 1/4 OF SEC. 34  
 SUMP #2 : 700'S AND 1300' W }

**FINAL PROOF SURVEY**  
UNDER

Application No. G-4742 Permit No. G-4462  
IN NAME OF

*Steven Williams & David Oswald*

Surveyed SEPT. 19 1974, by L. J. Lath