


WATER RIGHT SURVEY

FOR

MARC SAUCY

T. 7 S. R. 3 WWM Sec. 12 Marion County, Oregon.

1/4 cor. N. Line Sec. 12

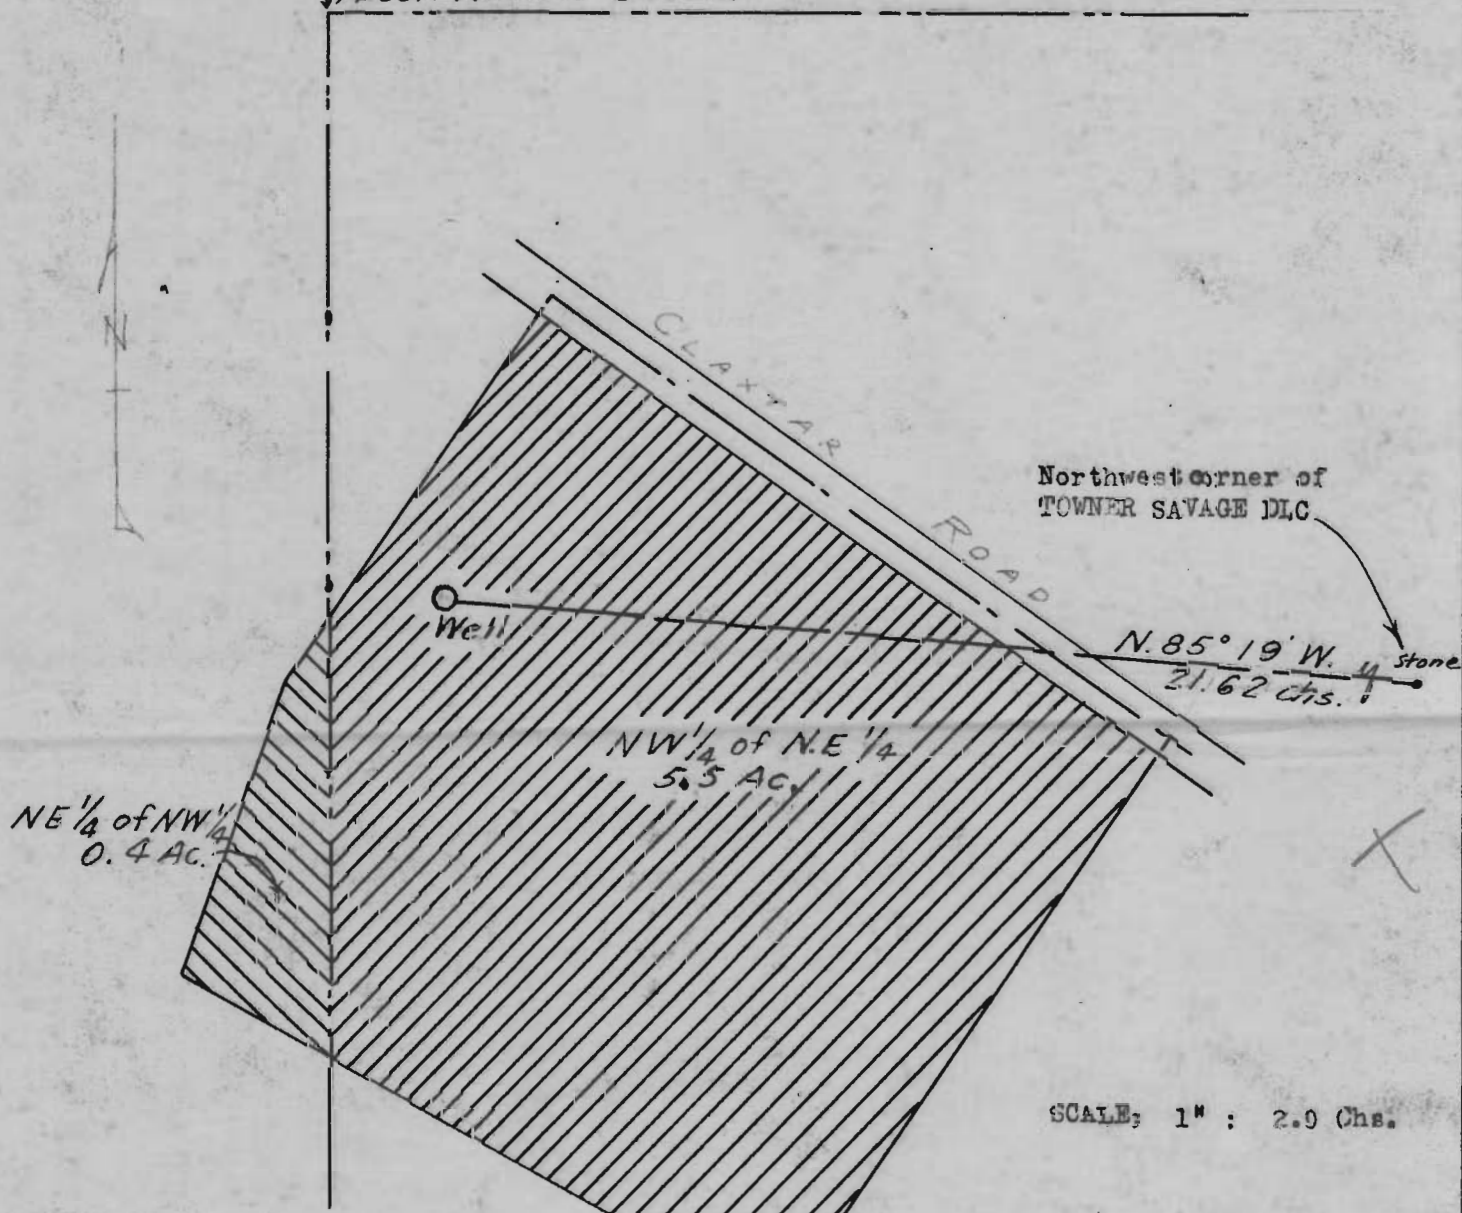

SCALE: 1" : 2.0 Chs.

Total acreage-- 5.9 acres

REGISTERED
OREGON
LAND SURVEYOR

David F. Bates

JULY 7, 1944
DAVID F. BATES
24

Application No G-544
Permit No G-451

I, David F. Bates of 477 Court Street, Salem, Oregon, do hereby certify that this map was made from notes taken during an actual survey made by me on September 18, 1956.

David F. Bates

OREGON LAND SURVEYOR Certificate No. 24