


G-4577

T.35S. R.6W. W.M.

RECEIVED  
MAR 8 1978  
W.M. DISTRICT 14  
GRANTS

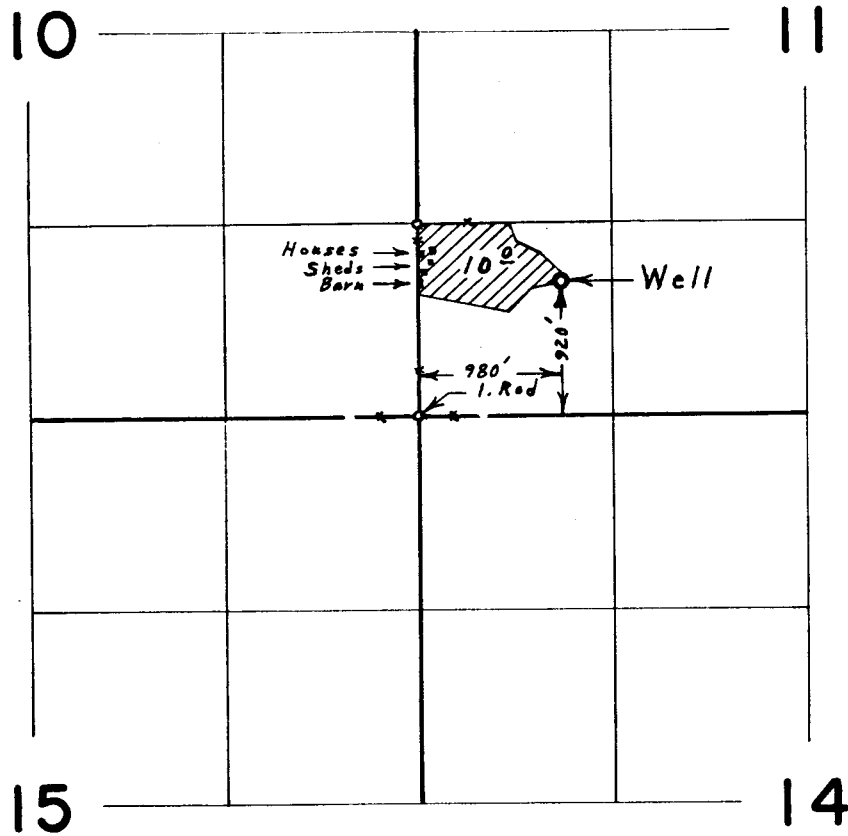

**FINAL PROOF SURVEY**  
UNDER

Application No. G-4846 Permit No. G-4577  
IN NAME OF

LEROY E. MERKEL

Surveyed April 17, 1974, by L. E. Gould

1974-K