

G-4730


T.38S.,R.5W.,W.M.

RECEIVED

NOV 24 1976

WM. DIST. 14
GRANTS PASS. ORE

38-5-22

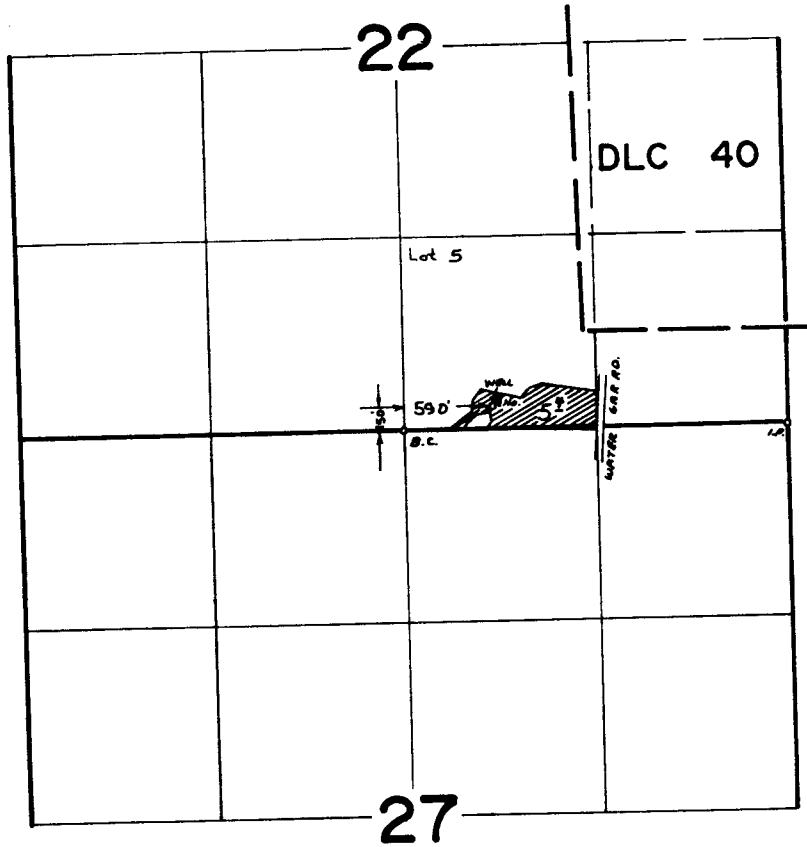

FINAL PROOF SURVEY
UNDER

Application No. G-5022. Permit No. G-4730.
IN NAME OF

AZEL L. AND LORA M. BLODGETT

Surveyed Oct. 4, 1974, by L. T. Tolh