RECEIVED
DEC 1970
STATE ENGINEER
SALEM OREGON

T. 13 & 14 S. R. 5 W. W.M.

RECEIVED
DEC 12 1969
STATE ENGINEER
SALEM. OREGON

Water Right Map

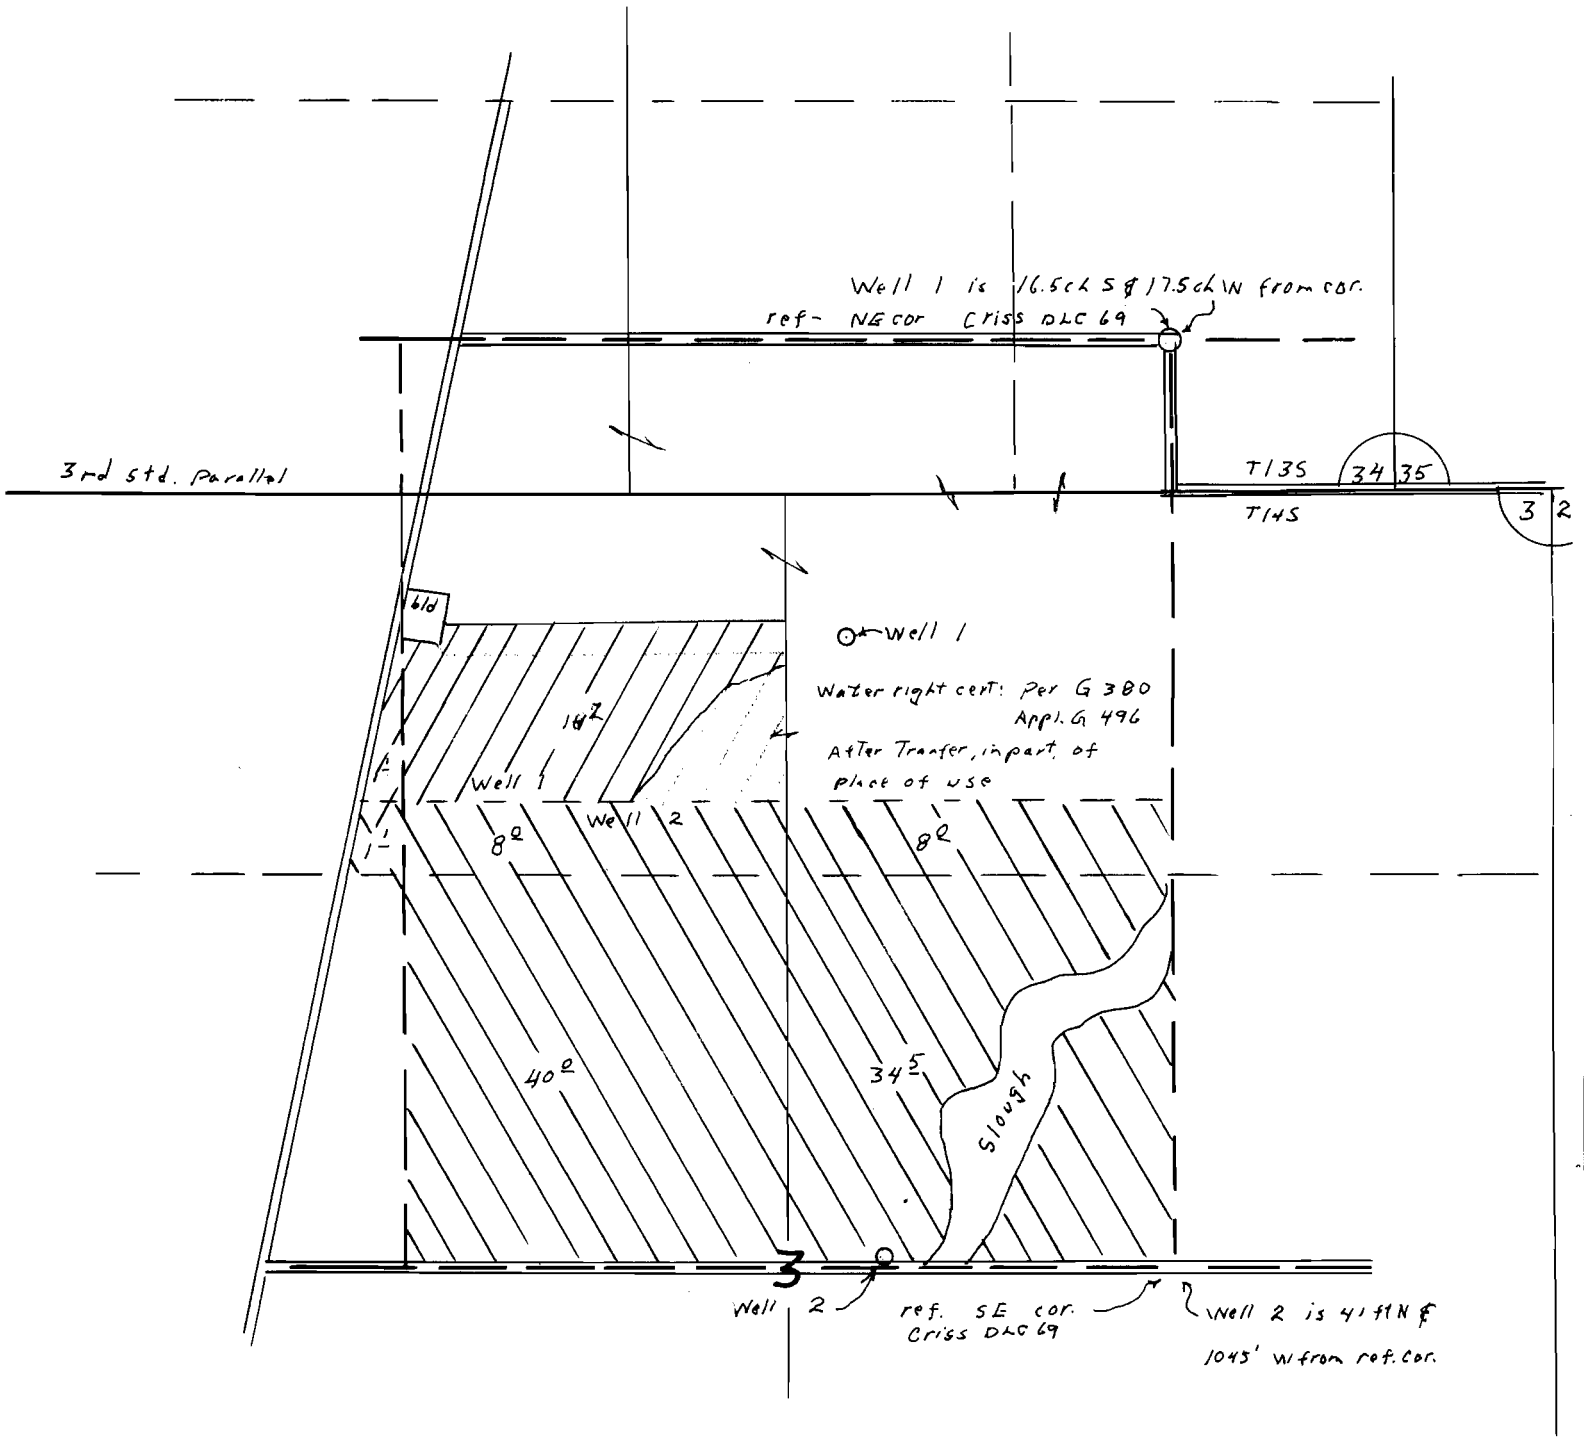

William L Franklin
2321 Highland Drive, Corvallis, Ore
July 1969 scale 1" = 660'

Application No. G-5056
Permit No. G 4766