


RECEIVED

APR 1 6 1970

STATE ENGINEER
SALEM OREGON



R-4-W

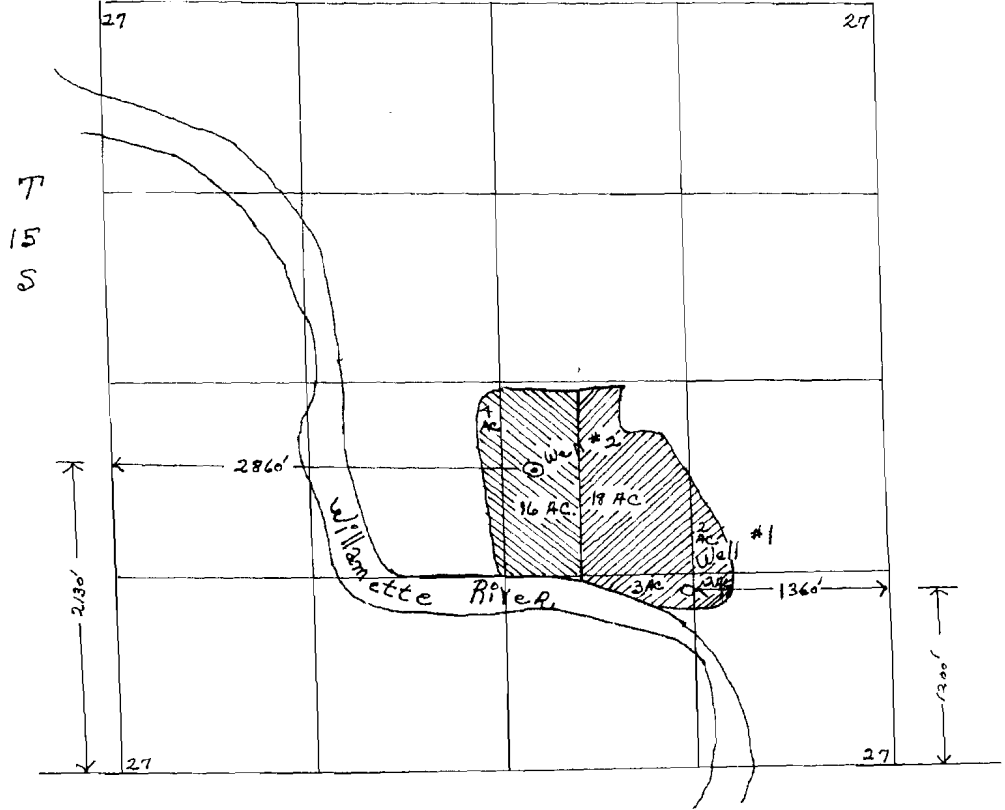

Traced from Map # DBG 4AA 12
Scale 1" = 1320'

G-5121 & 5122
G-4859 & G-4860