


G-4905

T.36S. R.6W. W.M.

RECEIVED

NOV 24 1976

WM. DIST. 14
GRANTS PASS, ORE.

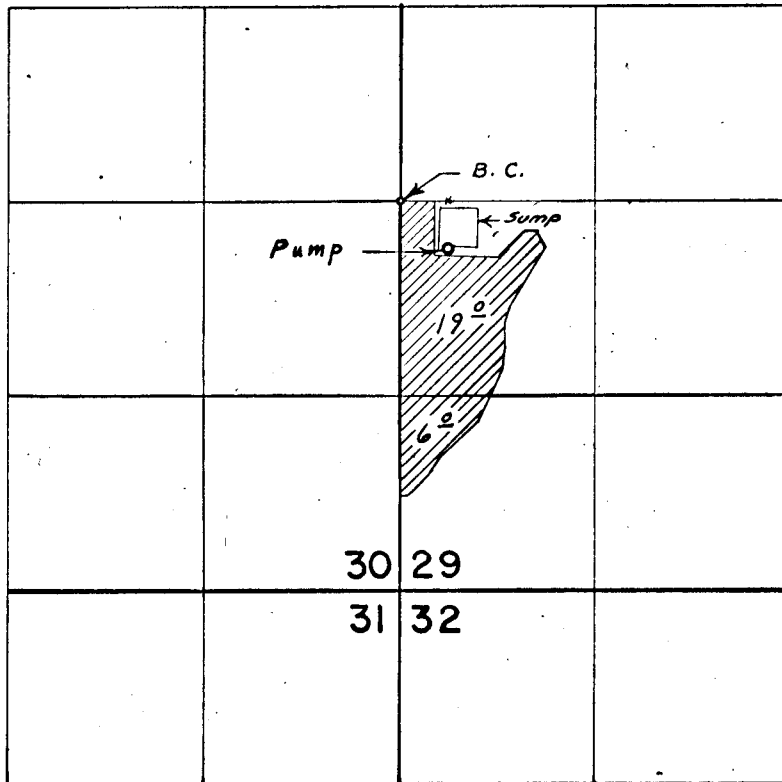

Well located 180' S. & 400' E. from W. 1/4 Cor. Sec. 29

FINAL PROOF SURVEY
UNDER

Application No. G-5174. Permit No. G-4905
IN NAME OF

MERLYN D. BOROUGH

Surveyed April 25, 1974, by L. E. Gould

1974-K