


1" = 200'
1" = 200'

Sec 27 T. 45 R. 1 W

Sec. 27 T. 45 R. 1 W

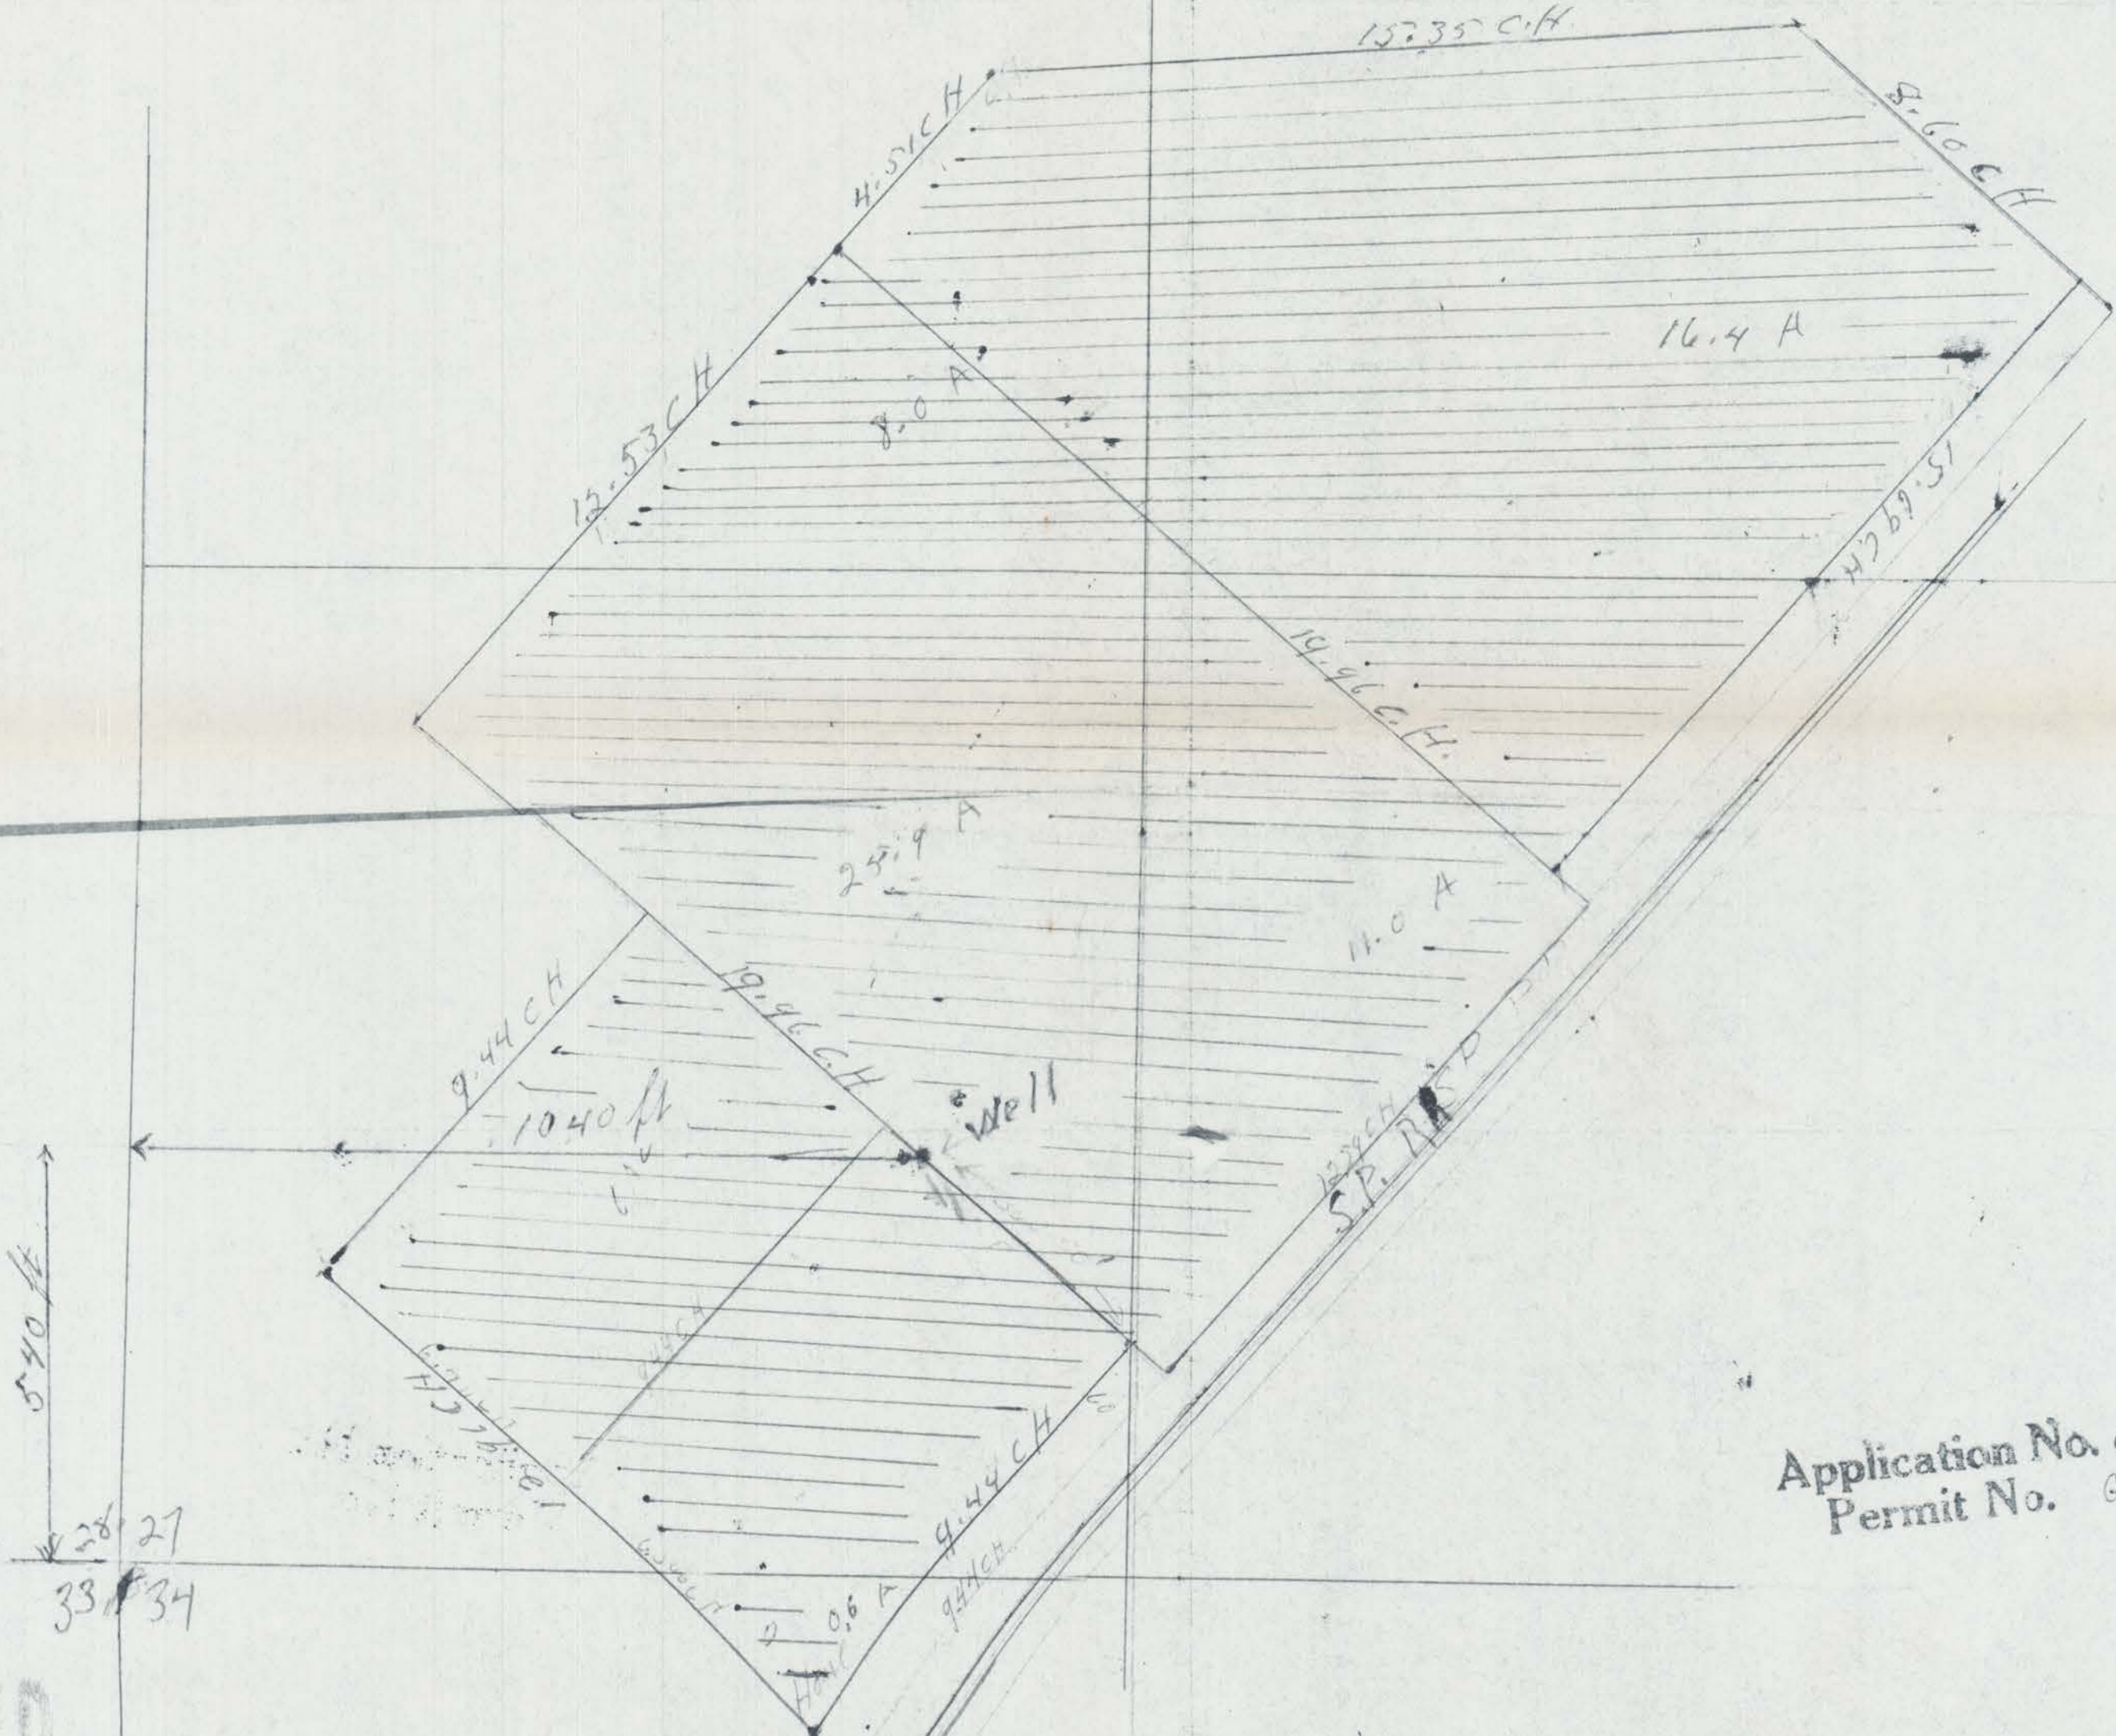

Application No. G-5511
Permit No. G-4925

RECEIVED
STATE OF
SALEM
NOV 1971
ENGINEER
REGON

Hubbard