


T.5 N. R.29 E. W.M. .

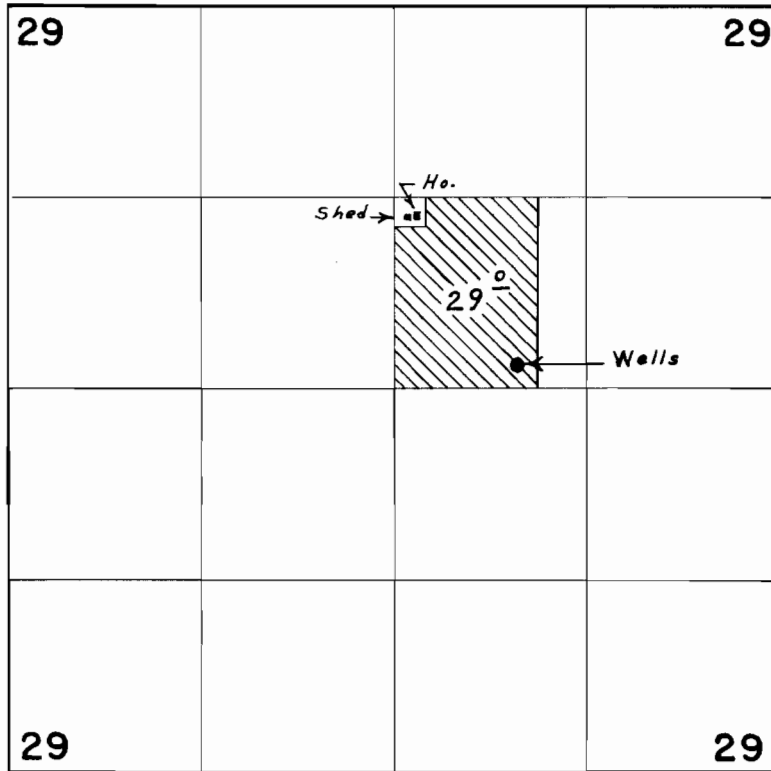

Wells located 170' N. & 840' E. from Center Sec. 29

FINAL PROOF SURVEY
UNDER

Application No. G-5694 Permit No. G-4943
IN NAME OF

J. H. KEITH

Surveyed April 18, 1973, by L. E. Gould