


MAP FOR ANNA ETZEL

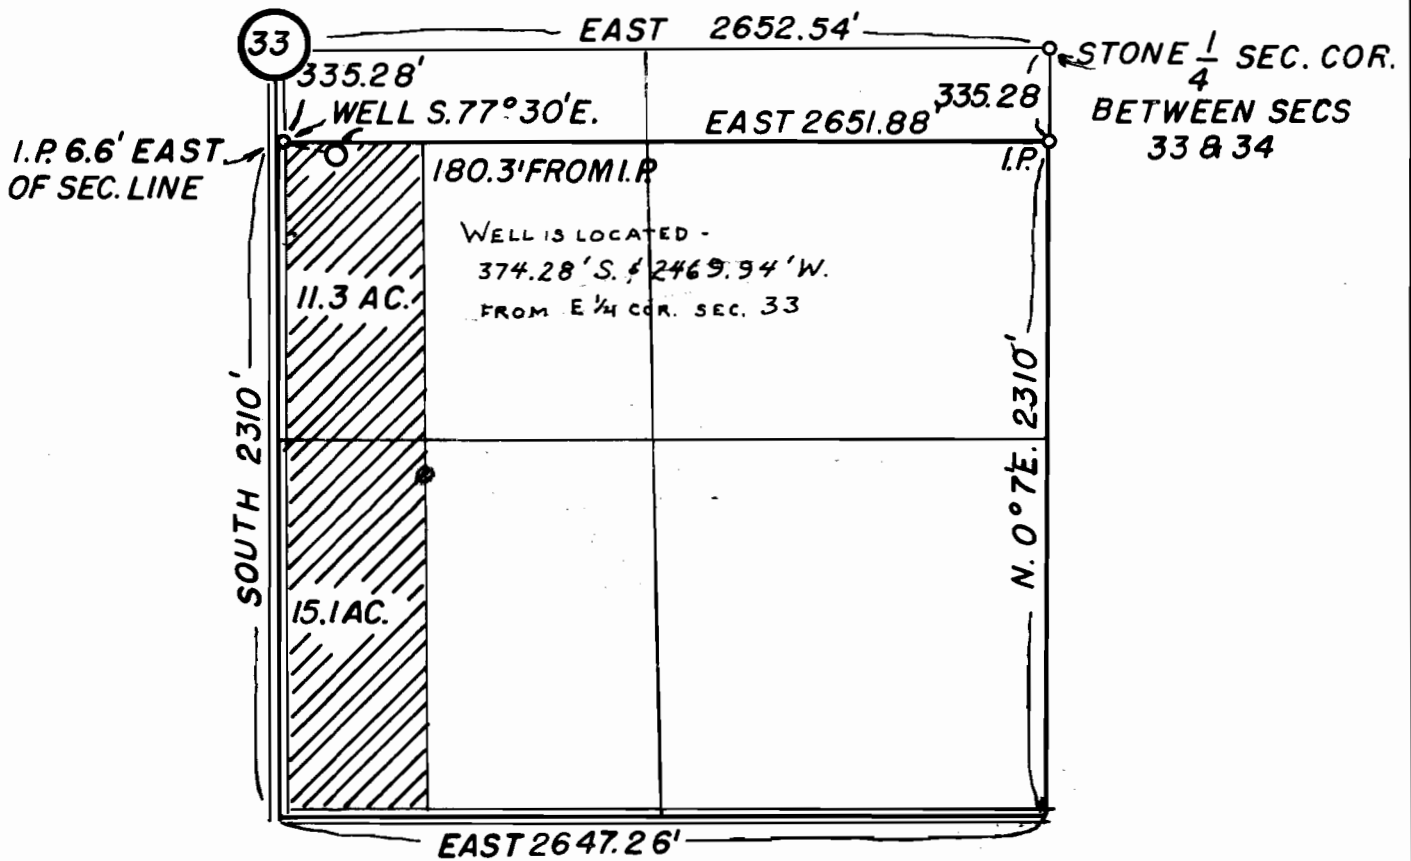

SEC. 33 T. 8 S. R. 2 W.

REGISTERED
OREGON
LAND SURVEYOR

Floyd L. Siegmund

SEPT. 6, 1948
FLOYD L. SIEGMUND
189

Application No. G-631
Permit No. G-513

Scale 1" = 10 chns