


Permit: G 5167
 Volume: 5
 Strm: 2 WELLS
 Trib: LOUSE CR
 Priority: 9/07/72

T.35S. R.5 W. W.M.

RECEIVED
 MAY 1 1979
 WM. DIST. 14
 GRANTS PASS, ORE

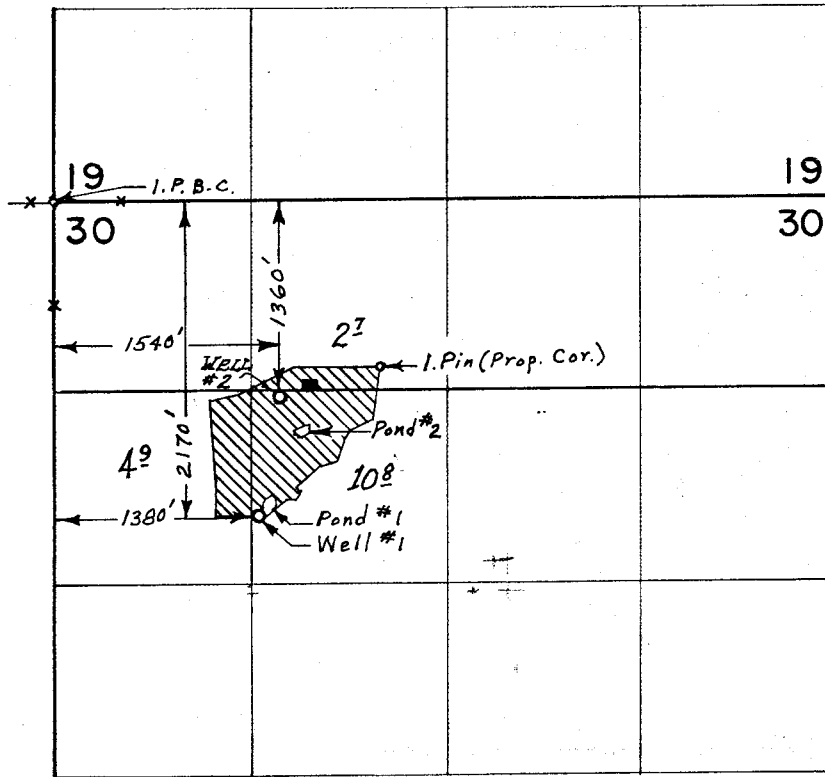

FINAL PROOF SURVEY
 UNDER

Application No. G-5893 Permit No. G-5167
 IN NAME OF
GEORGE RANDOLPH BLANKENSHIP

Surveyed April 2, 1975
May 17, 1974, by L. E. Gould
 REVISED JUNE 25, 1977 L.M. TOLL