


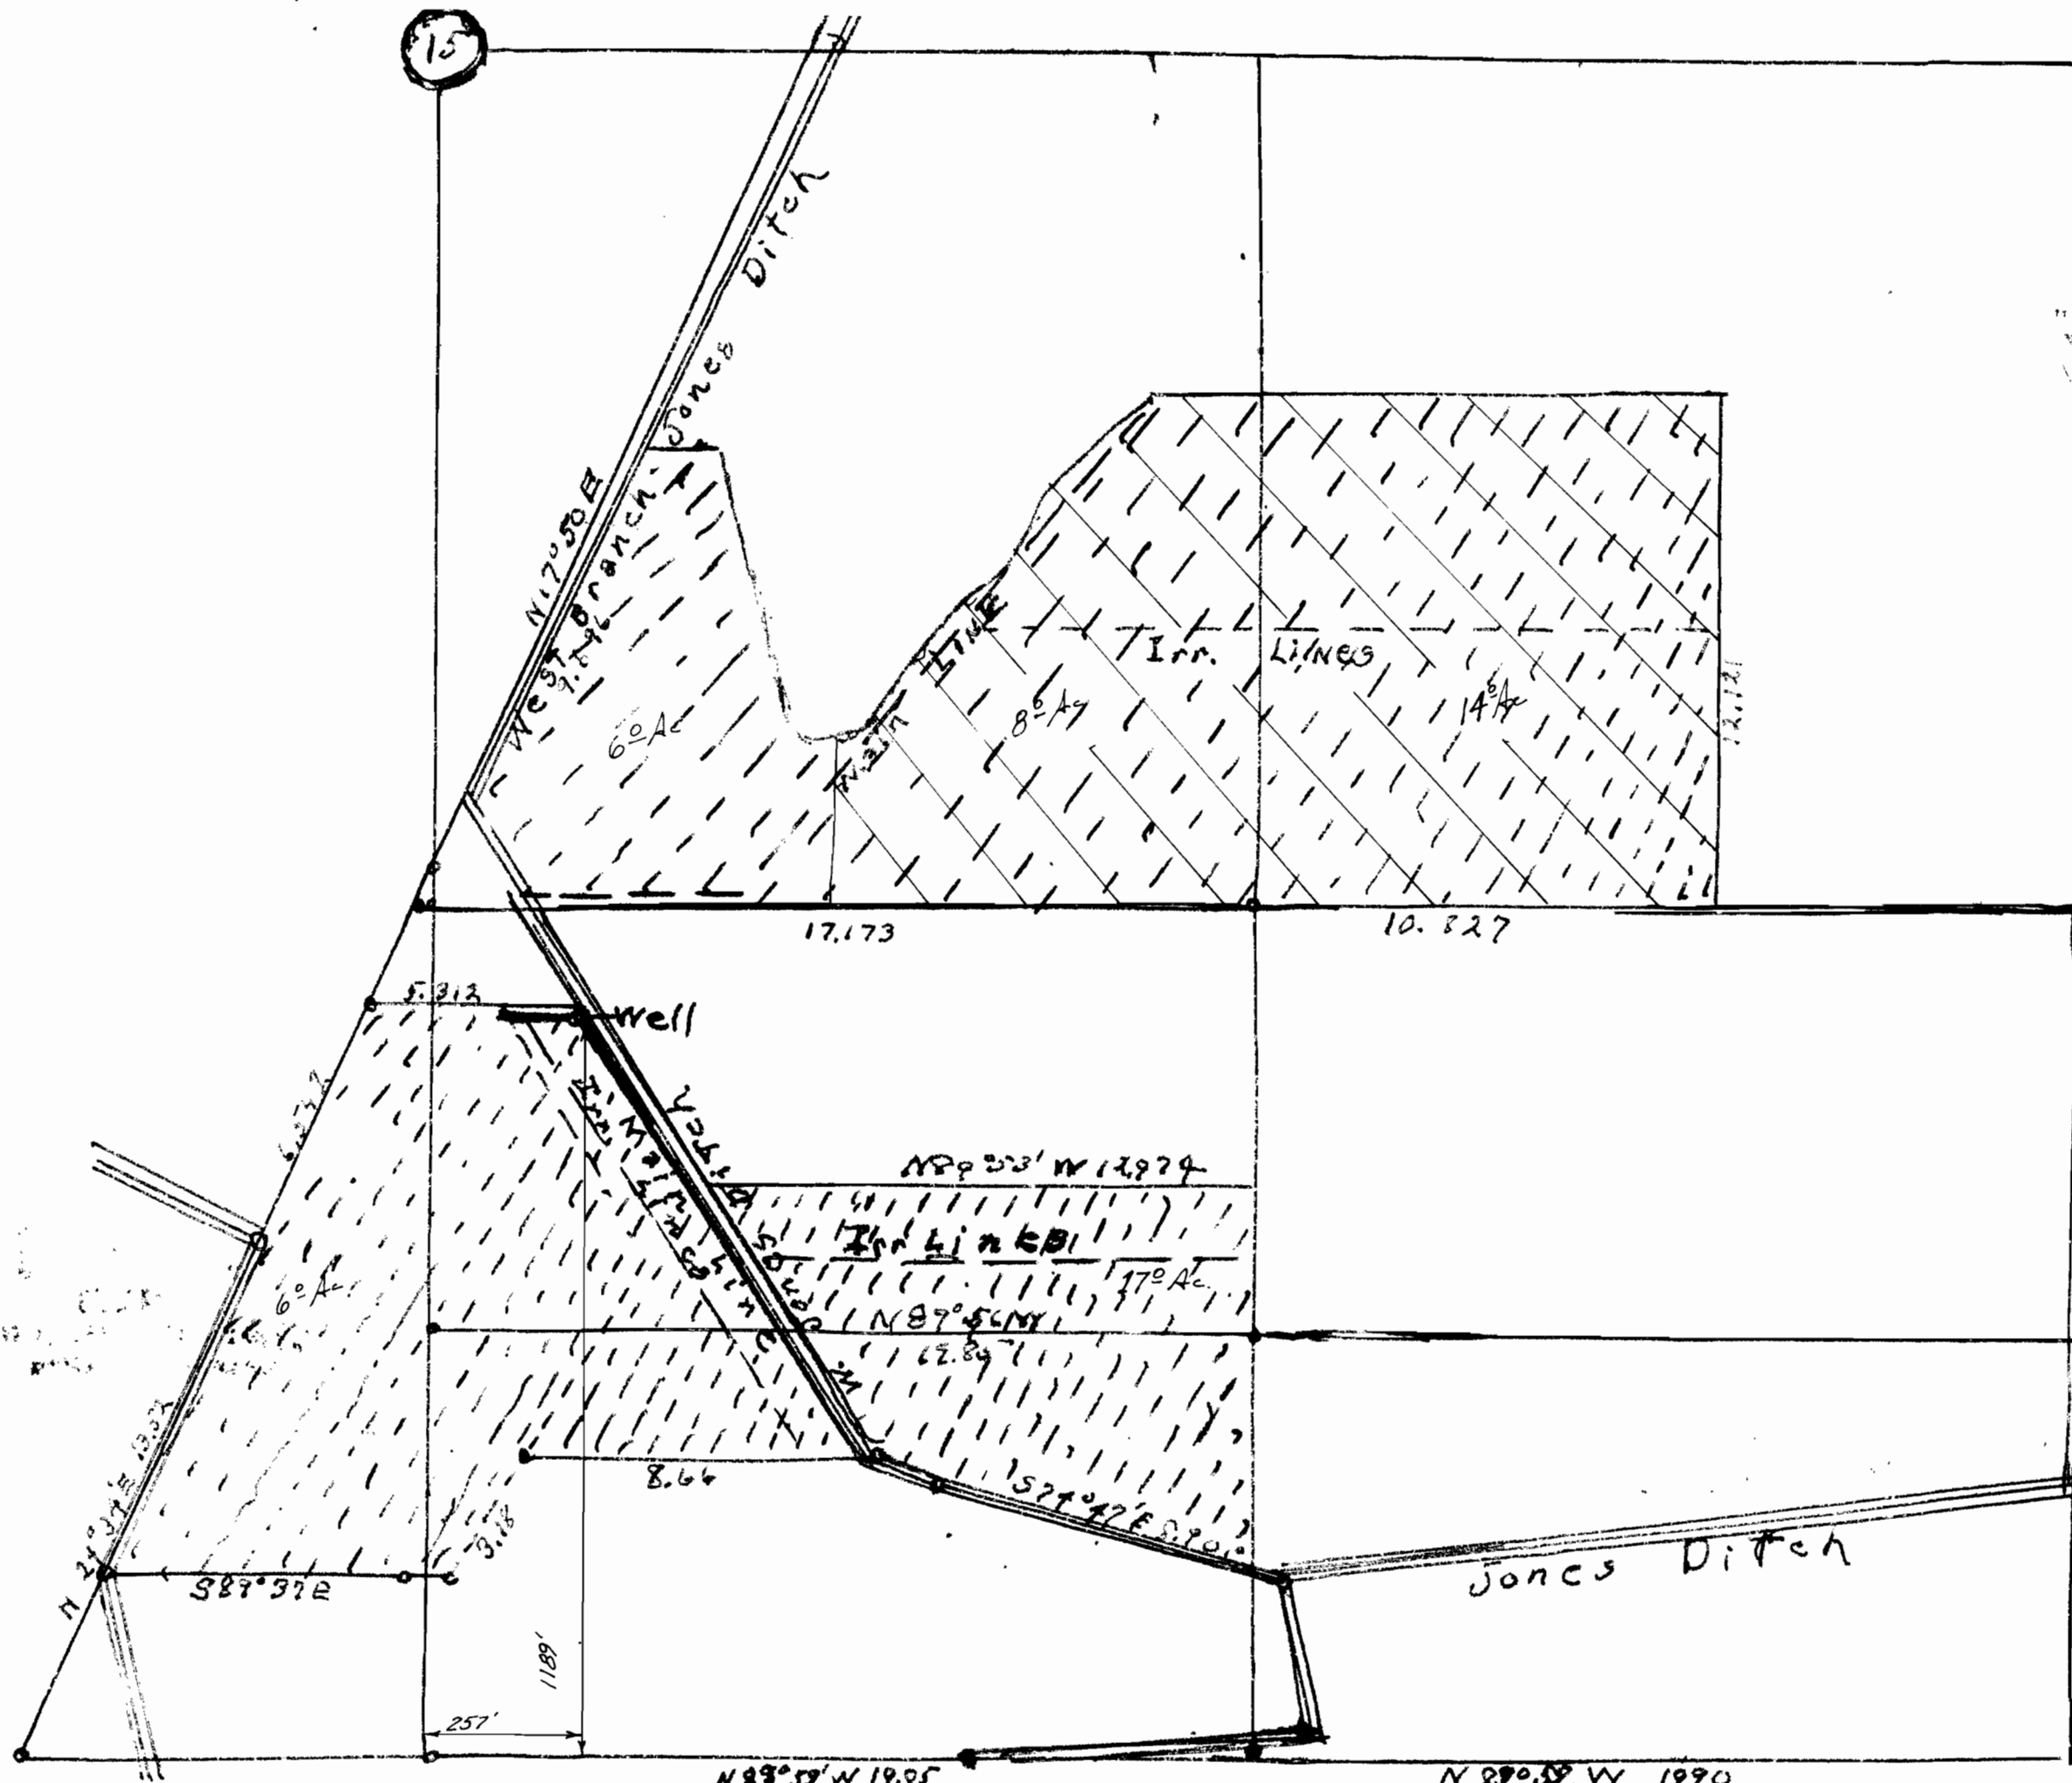

RECEIVED
 APR 24 1973
 STATE ENGINEER
 SALEM, OREGON

Scale
 1 inch = 264' on 4 chains

Application No. 10001
 Permit No. 5169

SE1 SE1 - SW1 SE1 - SE1 SW1 Sec. 15