


# T.36S.R.5W.W.M.

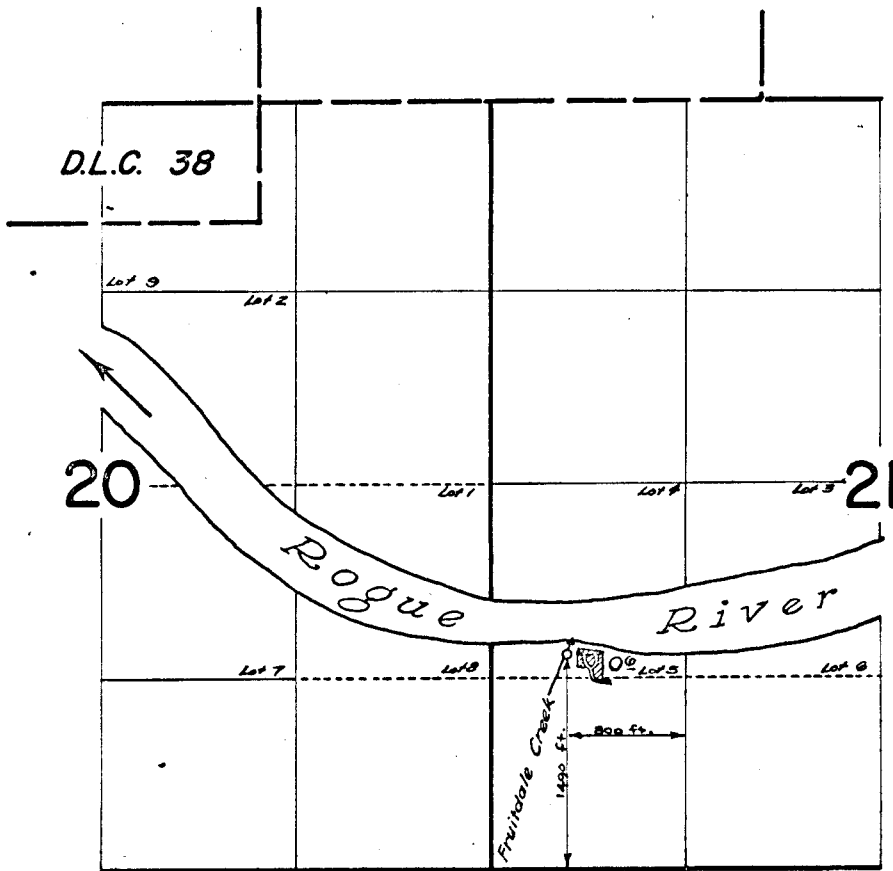

## FINAL PROOF SURVEY UNDER

Application No. 38784... Permit No. 28882...  
IN NAME OF

NAN B. CARNAHAN

Surveyed June 30, 1965., by *R. Jackson*