

FILED IN BOOK OF
SALES 1915


P. E. Wolf

Map

T. 5 S. R. 2. W.

Pump well: 350' N and 300' E from
the NW corner of Section 8

Letter 7-24-92
253

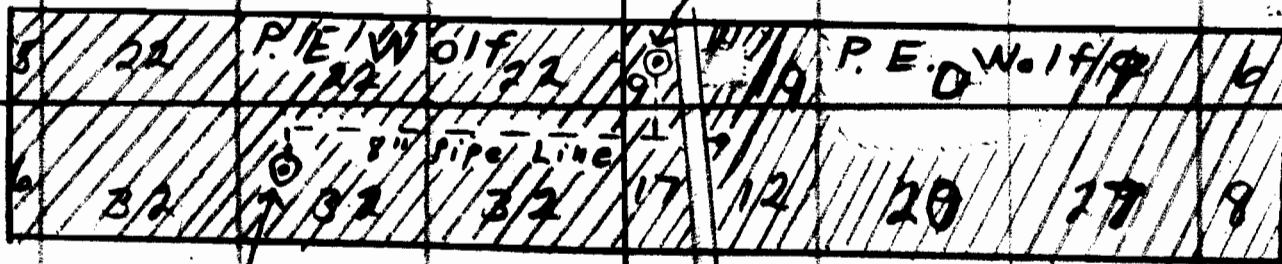

Turbine well: 2310' W and 450' S from
the NW corner of Section 8

Letter 7-14-12
253

Application No. C-5778
Permit No. C-5224

Scale 4" = 1 mile