


RECEIVED
APR 26 1971
STATE ENGINEER
SALEM, OREGON

T 34S R 2W WM

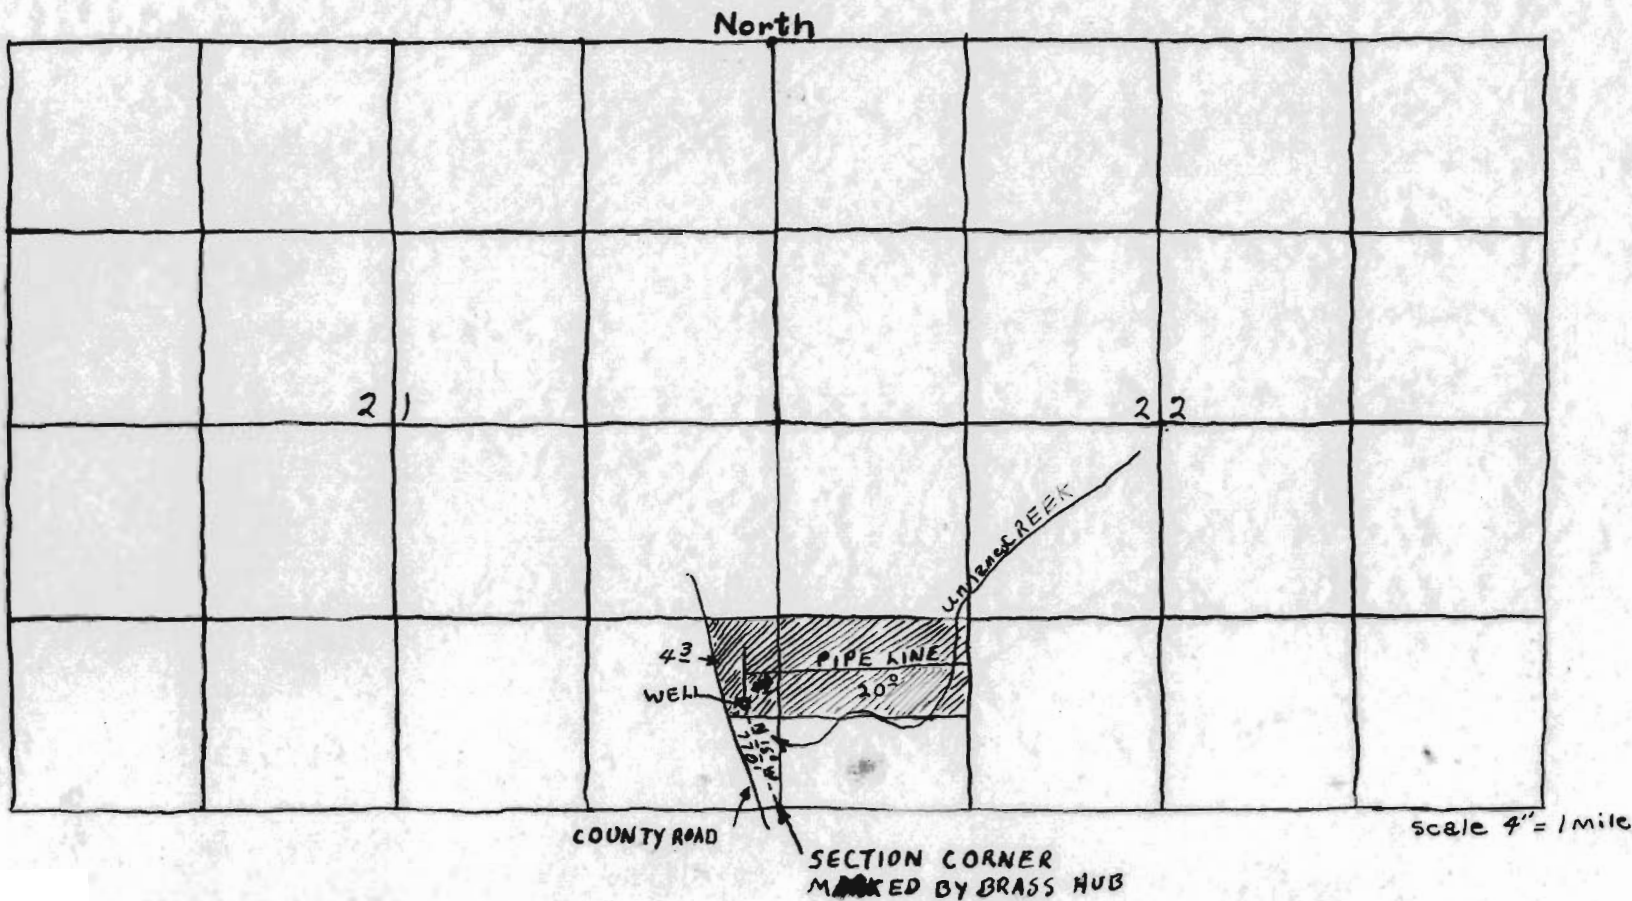

this map to accompany application
in the name of John Lancaster for
irrigation from well

Application No. G-5491
Permit No. G 5393