


RECEIVED
OCT 19 1971
STATE ENGINEER
SALEM, OREGON

RECEIVED
JUN 25 1971
STATE ENGINEER
SALEM, OREGON


T. 1 N. R. 3 W. W. M.

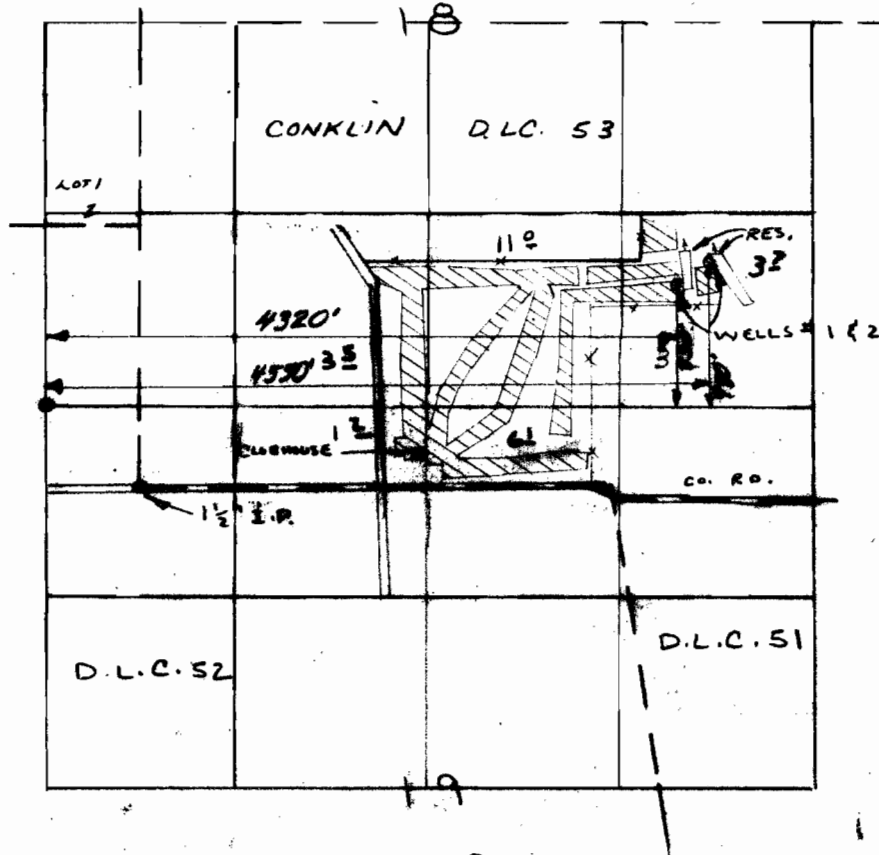

Application No. G 5496
Permit No. G 5396

APPLICATION MAP FOR
SUNSET GROVE GOLF CLUB INC
APPLICATION G-5496
SCALE 4 in. = 1 MILE

RECEIVED
JUN 25 1971
STATE ENGINEER
SALEM, OREGON

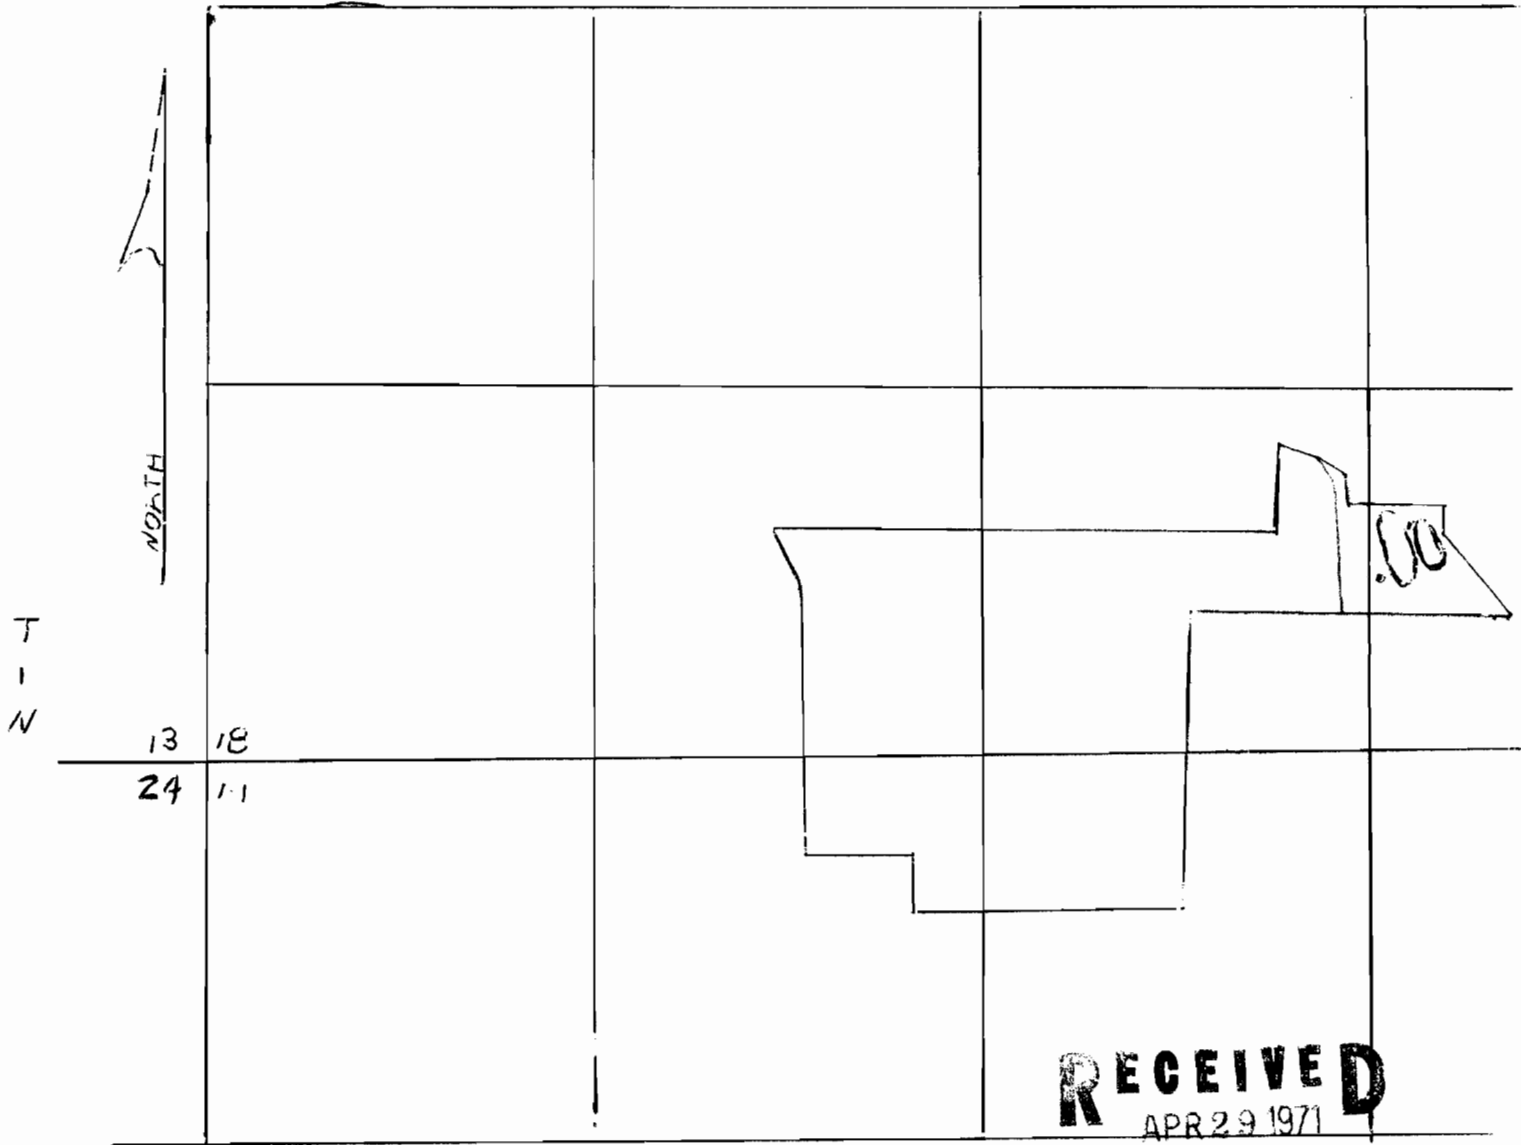

RECEIVED
APR 29 1971
STATE ENGINEER
SALEM, OREGON

Application No. G-5494
Permit No.

SCALE
1"=660'
REW

Use Final Proof Map & Legal description of Application
No. 40466