


RECEIVED

JUL 22 1981

WM. DIST. 14  
GRANTS PASS, ORE

T.39&40S., R.7&8W., W.M.

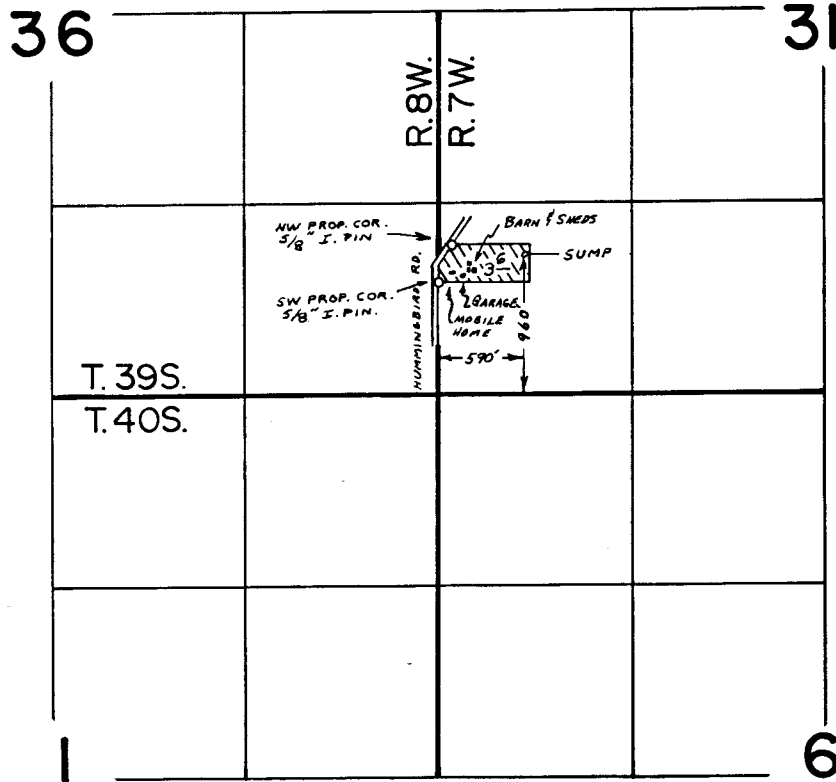

**FINAL PROOF SURVEY**  
UNDER

Application No. G-5608 Permit No. G-5454  
IN NAME OF

PHILIP L. PAQUIN

Surveyed AUG. 7 78 by B. SUND  
19.....

P.T.S. -1978-14-C