


RECEIVED  
SEP 30 1955  
STATE ENGINEER  
SALEM, OREGON

RECEIVED  
SEP 21 1955  
STATE ENGINEER  
SALEM, OREGON

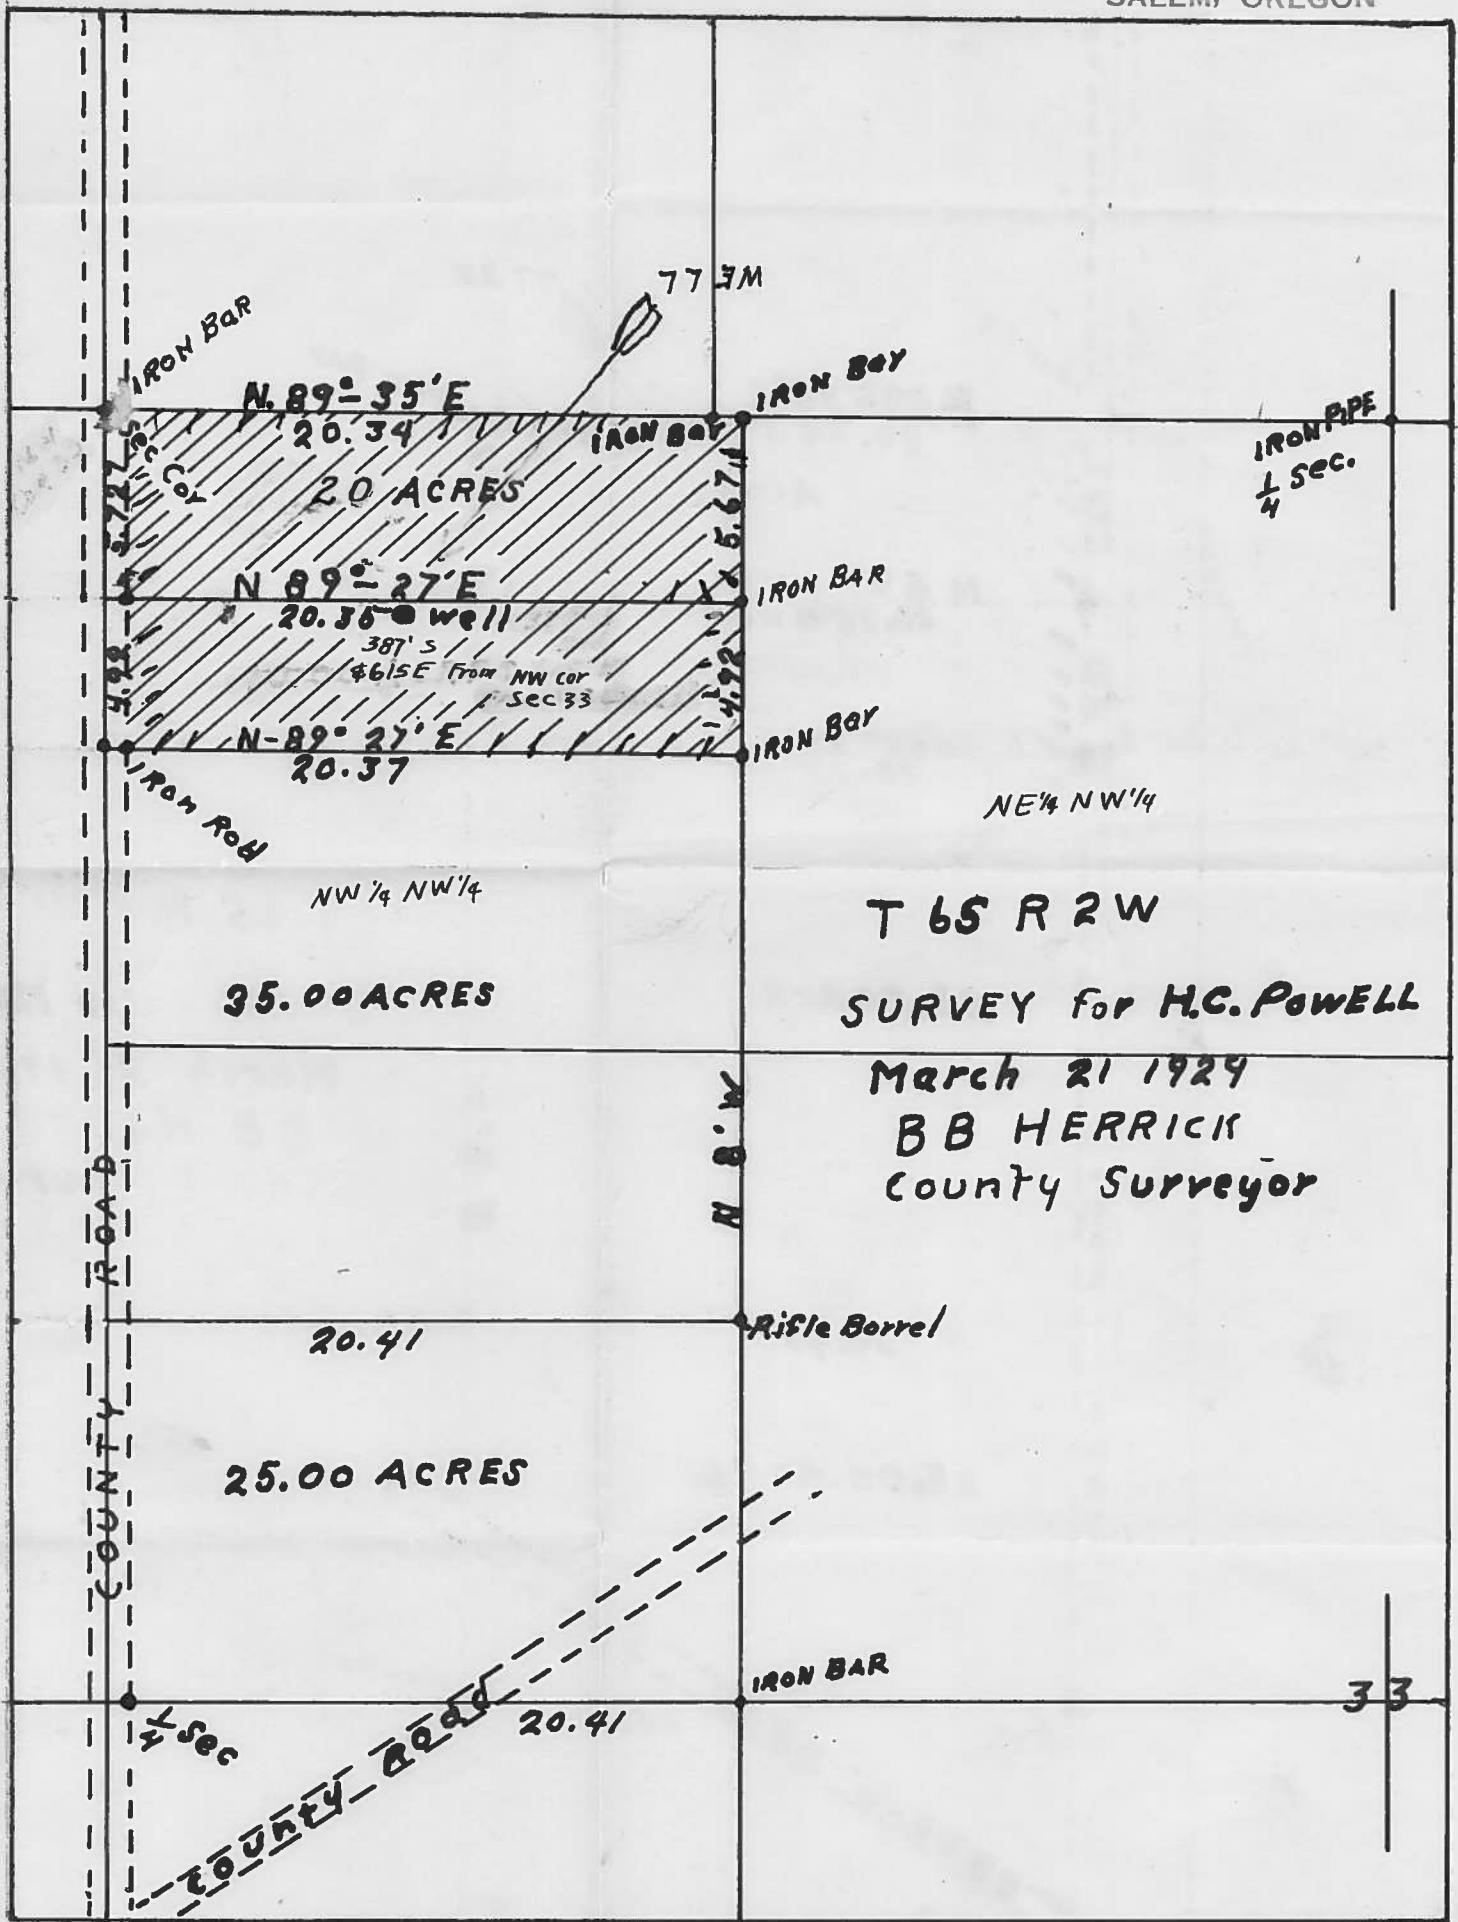

Scale 1" = 400'

Application No. G-149  
Permit No. 55

G-149