


1970
10/15/70
10/15/70

T.15 S.R.4 & 5 W.W.M.

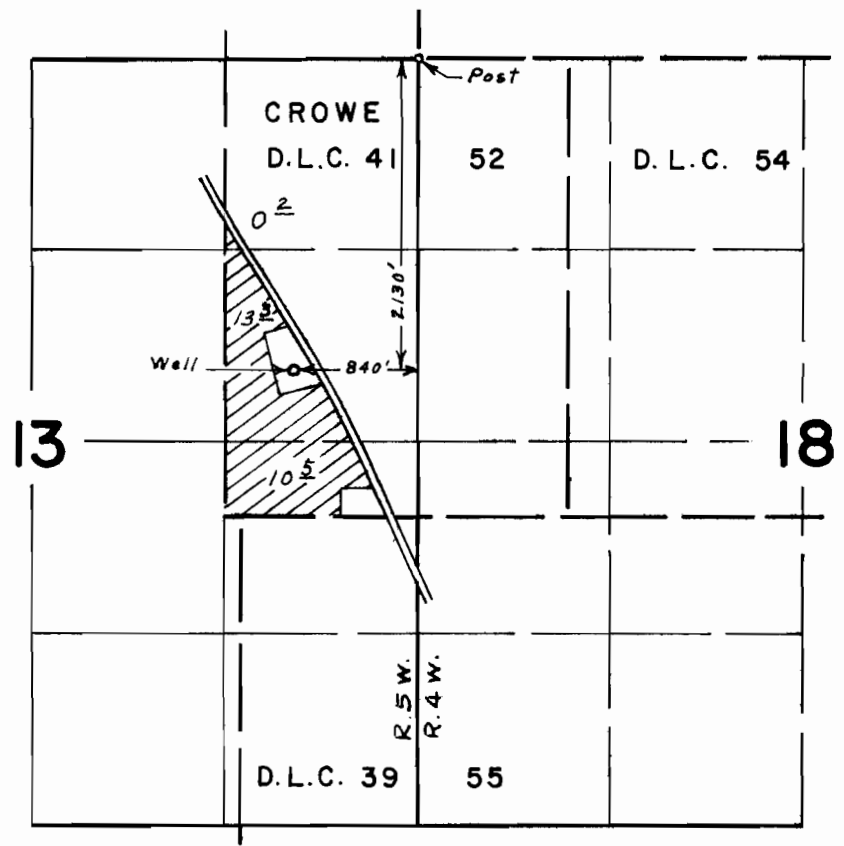

Application No. G 5722
Permit No. G 5523

GIBSON LAND & LIVESTOCK CO.