


T. 15 S. R. 4 & 5 W. W. M.

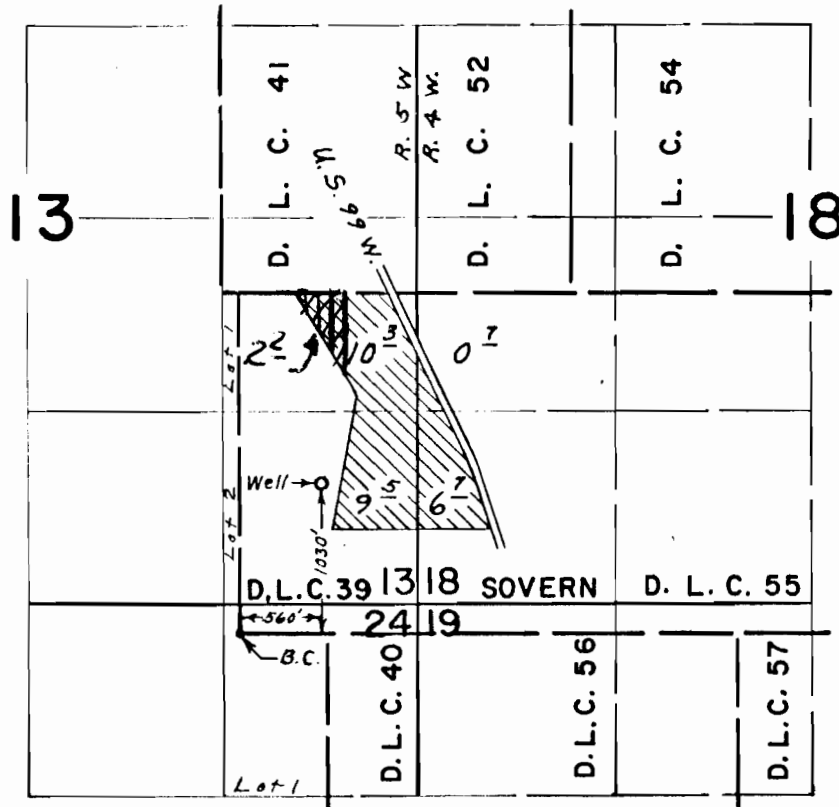

FINAL PROOF SURVEY UNDER

Application No. G-3926. Permit No. G-3686.
IN NAME OF

ALFRED & NINA NIELSON

Surveyed Aug. 26., 1970, by L. E. Gould.

Application No. G-5758
Permit No. G 5543