

Township 16S


Range 4W

W.M.

North

Section 9

Section corner marked  
by 1" iron pipe

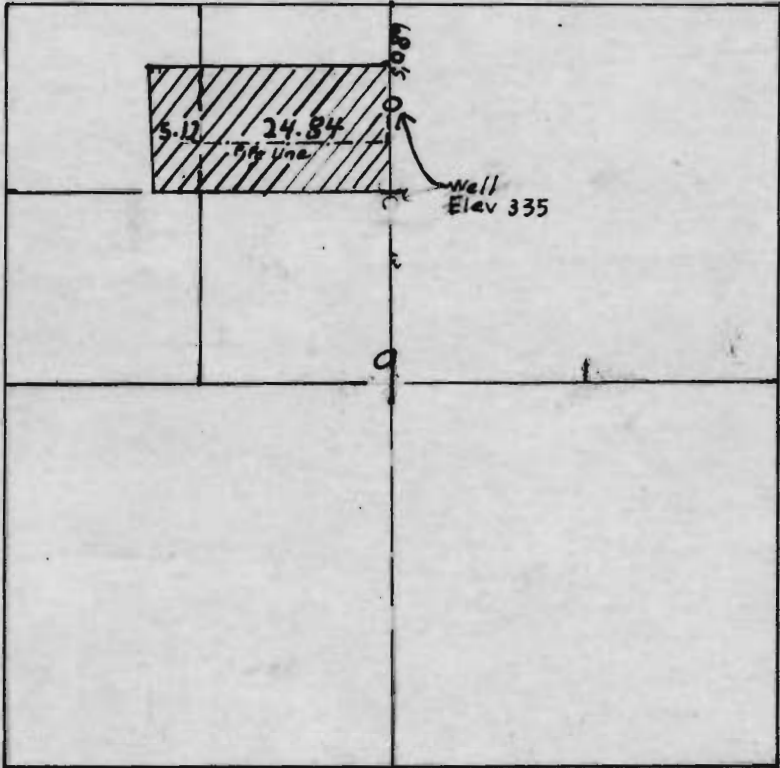

Scale:  $\frac{1}{4}'' = 1 \text{ Mile}$

Application No. G-643  
Permit No. G-559

RECEIVED  
MAY 9 1957  
STATE ENGINEER  
SALEM, OREGON