


RECEIVED
JUL 23 1972
STATE ENGINEER
SALEM, OREGON

Township 38S R5WWM
Scale 1" = 400'

RECEIVED
JUL 28 1972
STATE ENGINEER
SALEM, OREGON

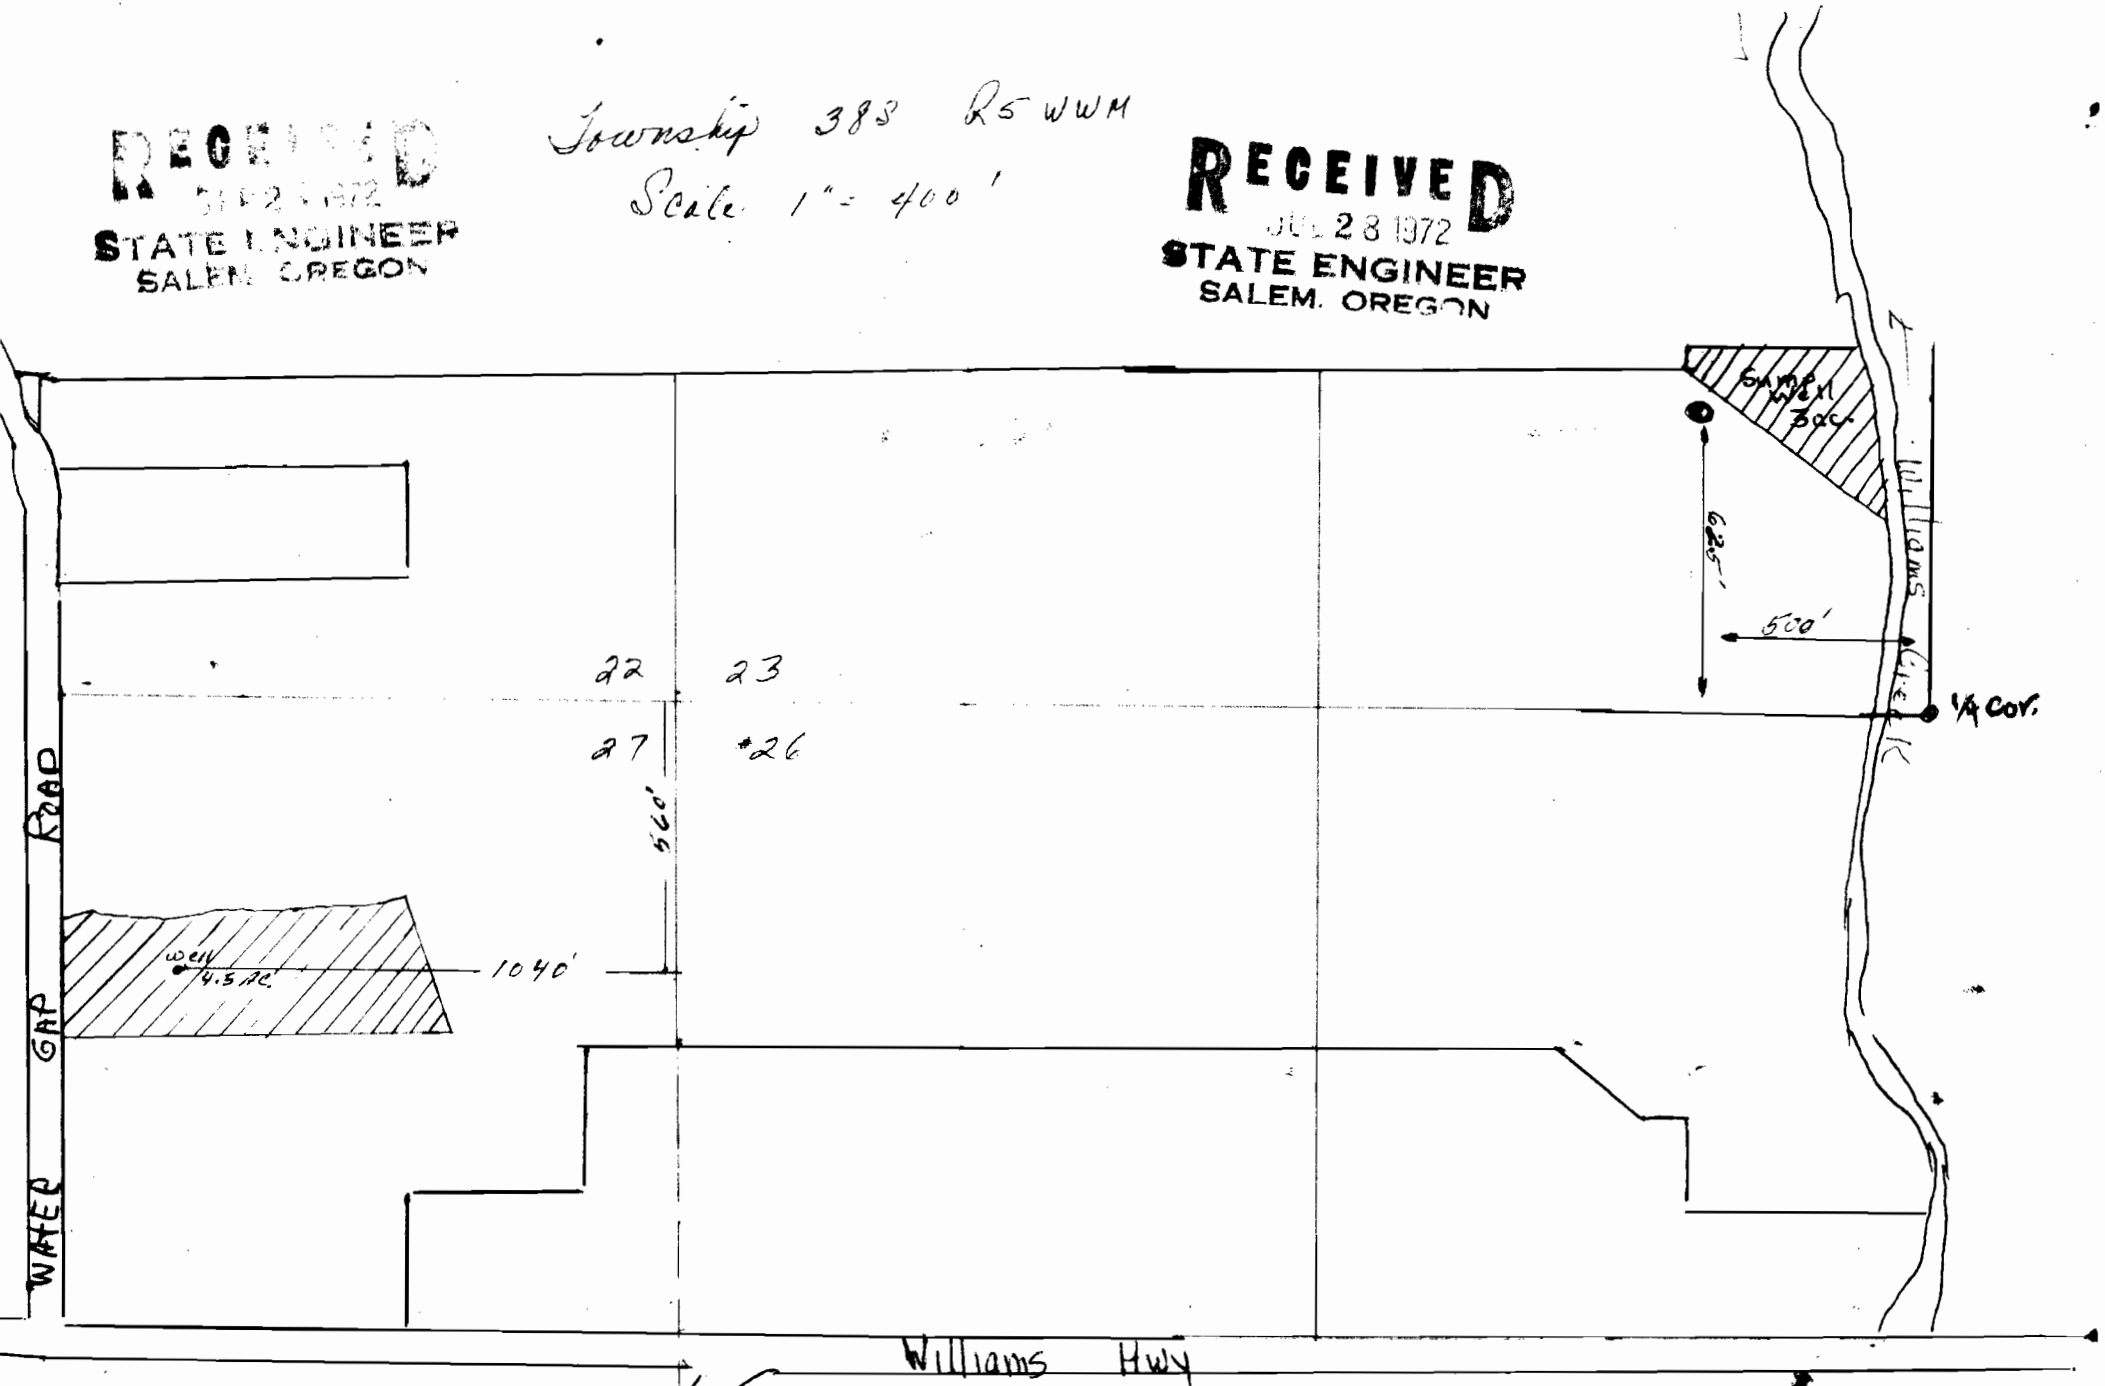

Application No. G-5852
Permit No. G5591