


# T.1N. R.3E. W.M.

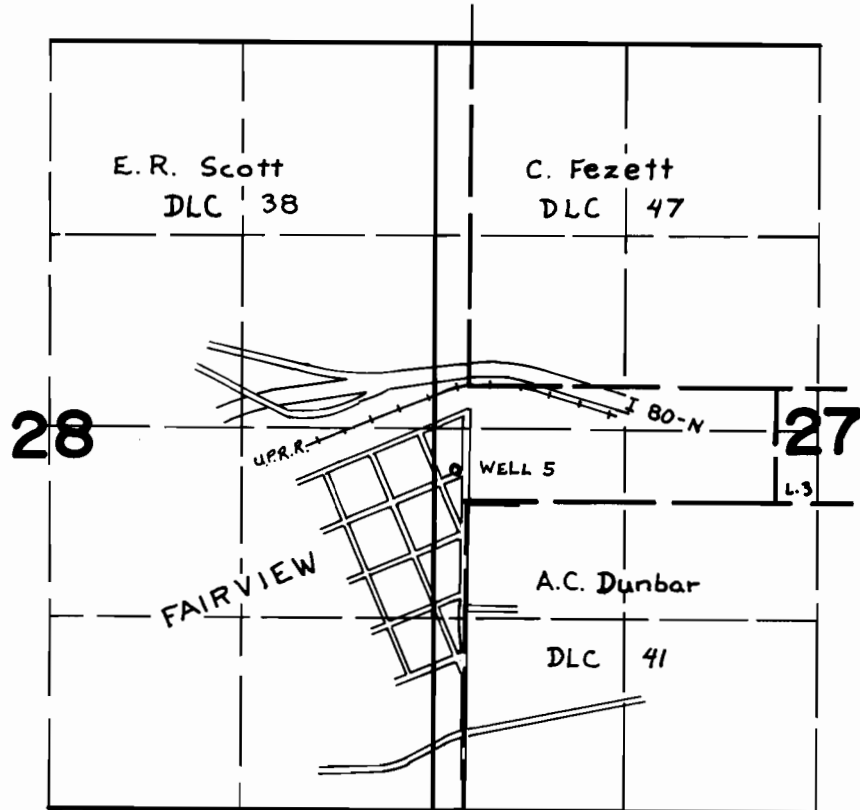

Well Located 275'S & 150'E from W 1/4 cor. Sec 27

## FINAL PROOF SURVEY UNDER

Application No. G-5857. Permit No. G-5594  
IN NAME OF

CITY OF FAIRVIEW

Surveyed AUG. 12, 1976., by L.E. GOULD.....