


Township 16 S Range 4 W WM
Section 9

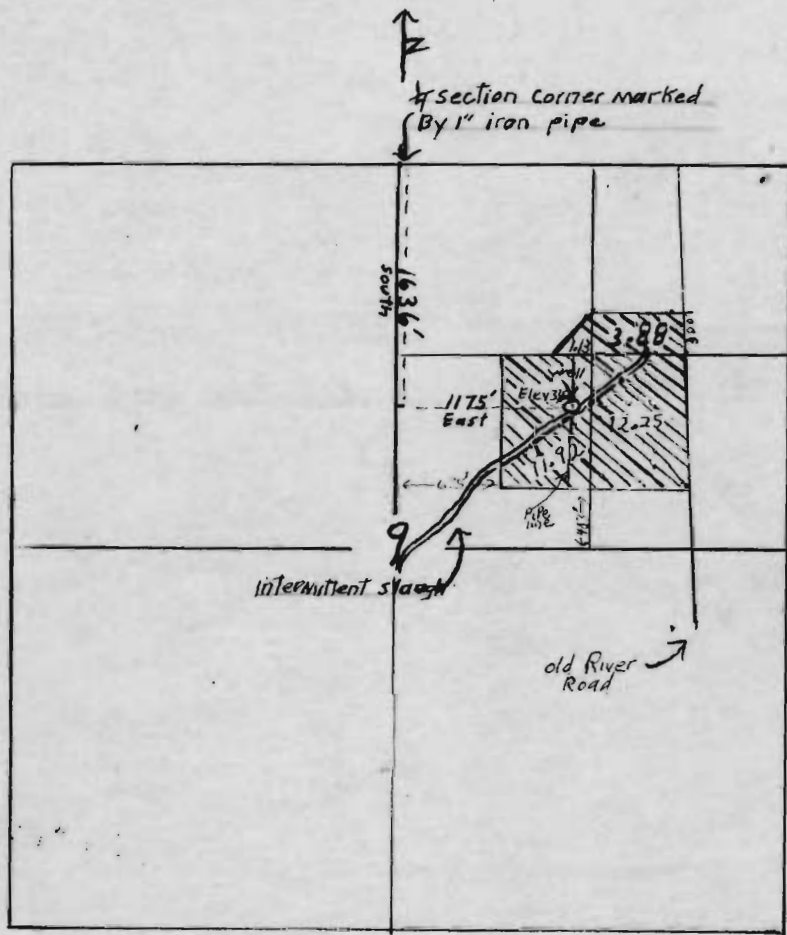

Scale: 4" = 1 mile

Application No. G-644
Permit No. G-560

RECEIVED
MAY 9 1957
STATE ENGINEER
SALEM, OREGON