


Township 16S Range 4W W.M.

Section 9

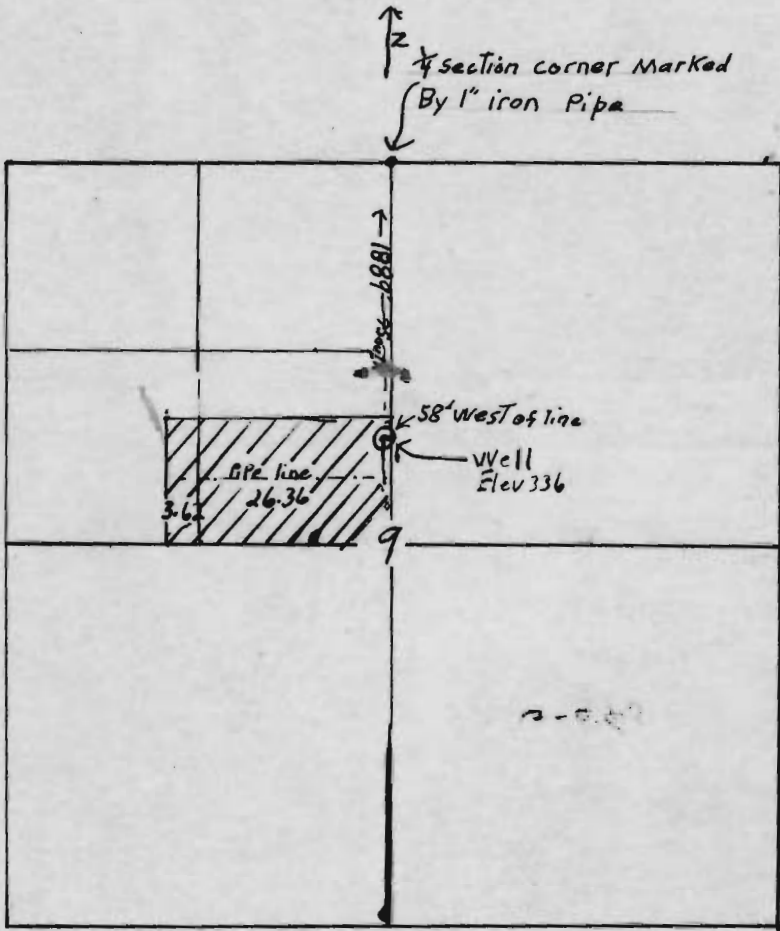

Scale: 4" = 1 Mile

Application No. G-645
Permit No. G-561

RECEIVED
MAY 9 1957
STATE ENGINEER
SALEM, OREGON