

RECEIVED


FEB 26 1975

STATE ENGINEER
SALEM, OREGON

RECEIVED

MAR 26 1975

STATE ENGINEER
SALEM, OREGON

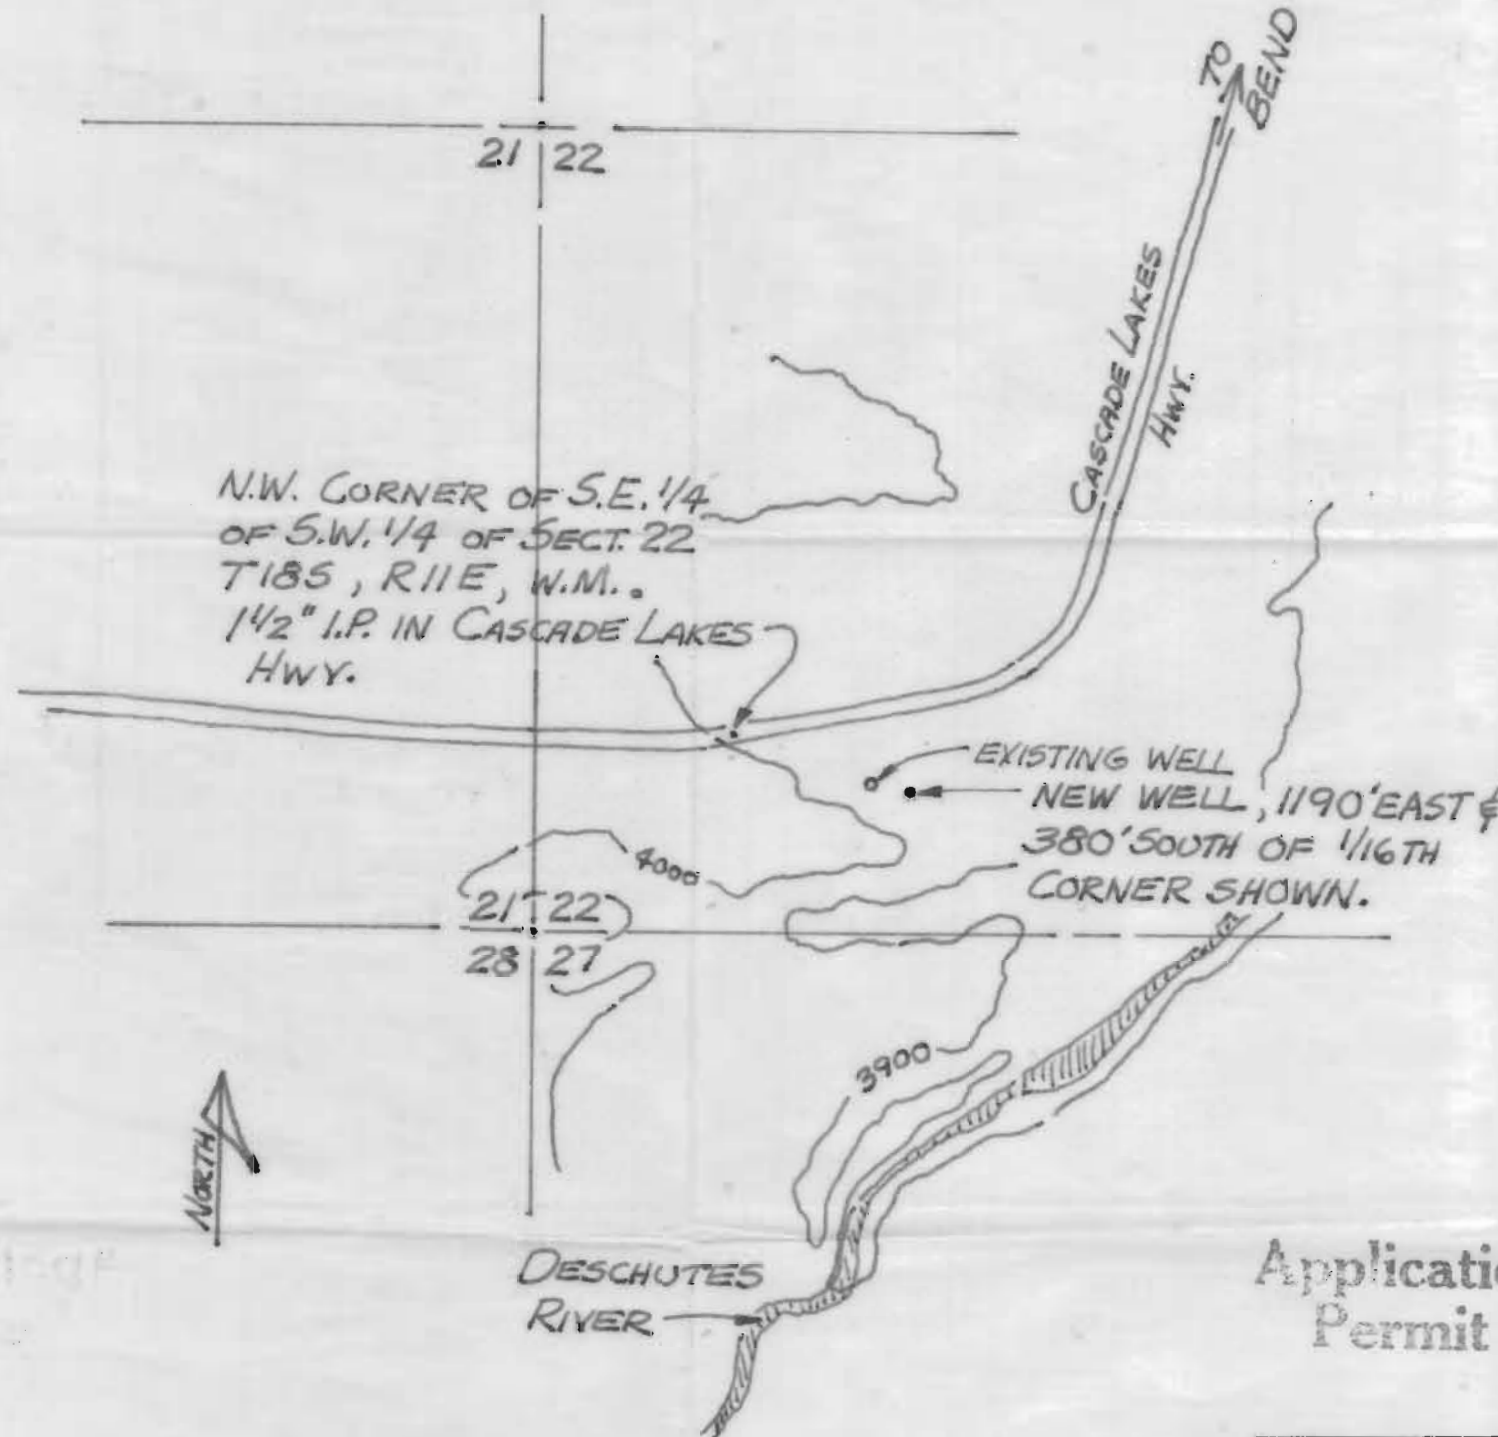

Application No. G-6864
Permit No. G 5686

SCALE	REVISIONS	BY	DATE
1"=1250'			
DATE			
2-19-75			
DR'N.	CKD.		
D.L.	D.P.		
AP'VD.			
TITLE	NO.		
7 TH MTN.-PROPOSED WELL	7MT-175		