


T. 4N. R. 29E. W. M.

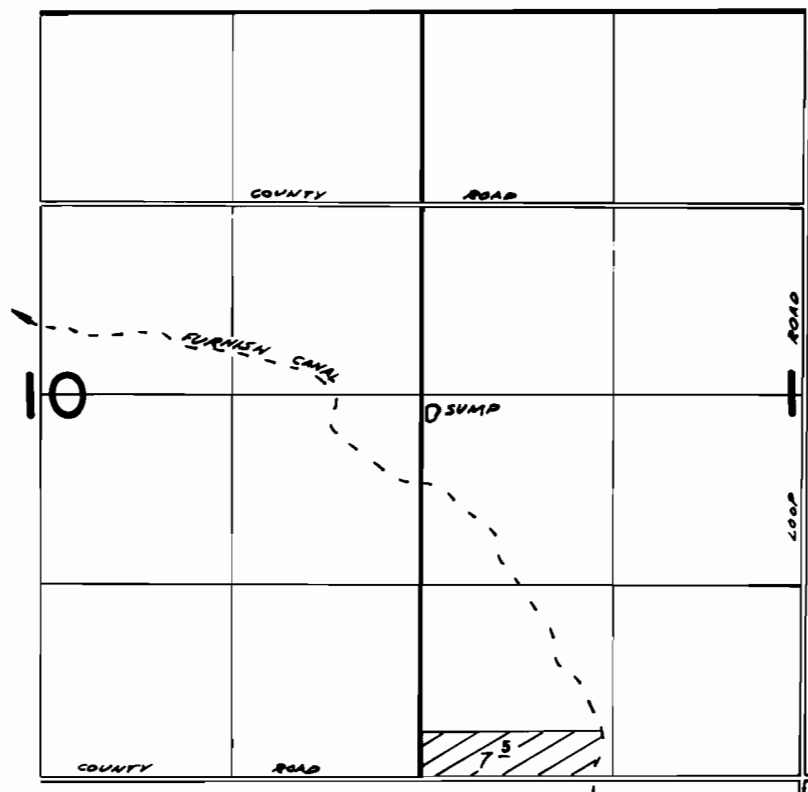

SUMP LOCATED 110'S. & 80' W. FROM NW COR SEC 11

FINAL PROOF SURVEY
UNDER

Application No. G-5991 Permit No. G-5730.
IN NAME OF

ROBERT M. POLSTON.

Surveyed 2-7 1979, by R. BARWIN.