


T. 33 S. R. 6 W. Sec. 4

Application No. 66001 & 51274
Permit No. 65745

OCT 15 1971
STATE ENGINEER
SALMON, OREGON

SEP 27 1971
SALMON

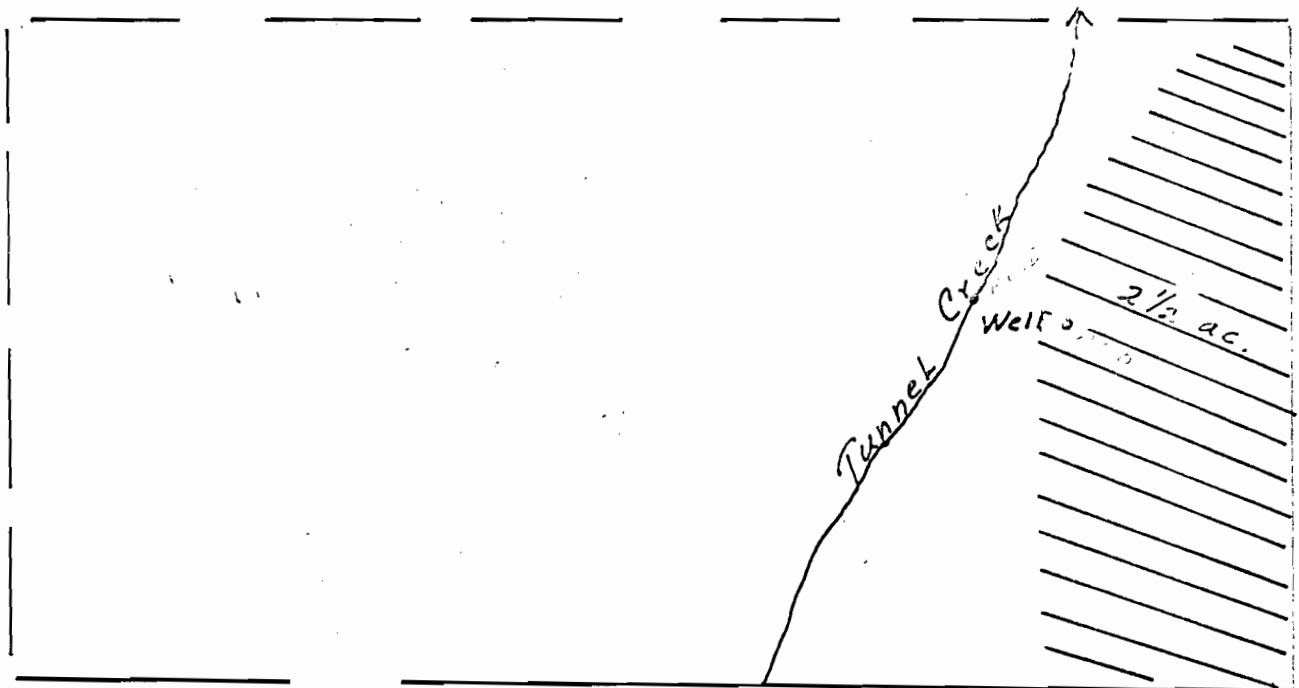

Well - 1,000' N., 240' W.
from SE. Cor. Sec. 4

Tunnel Cr. - 1030' N., 320' W.
from SE. Cor. Sec. 4

Application No. 51274
Permit No.

1" = 200'