
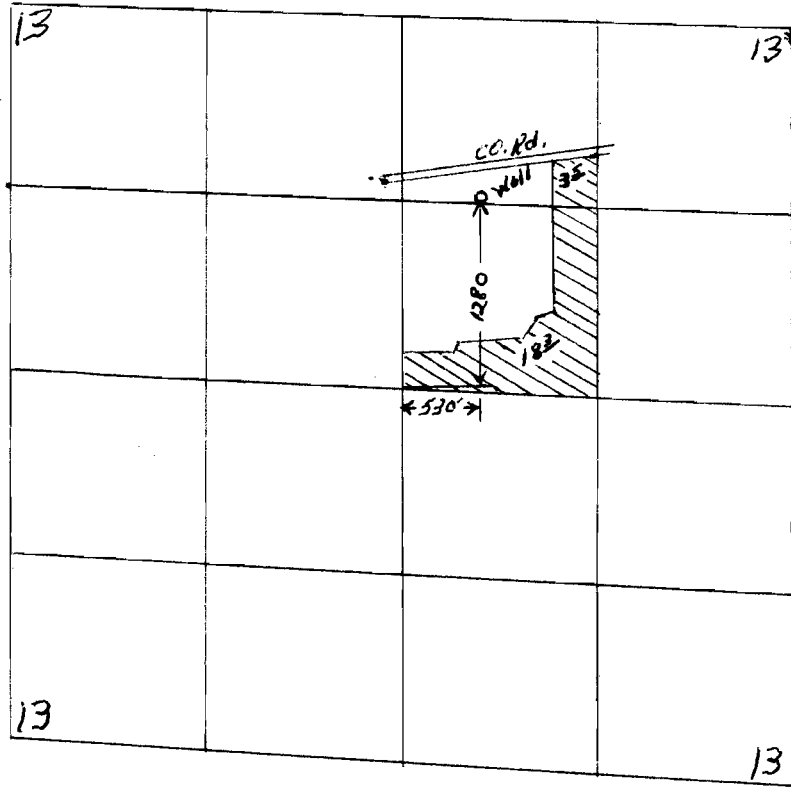


RECEIVED
APR 16 1973
STATE ENGINEER
SALEM, OREGON

T. 2 S. R. 3 W. W. M.

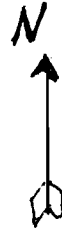

Scale 4" = 1 mile

Water Permit applied for

Application No. B-6073
Permit No. G 5760