


R-4E

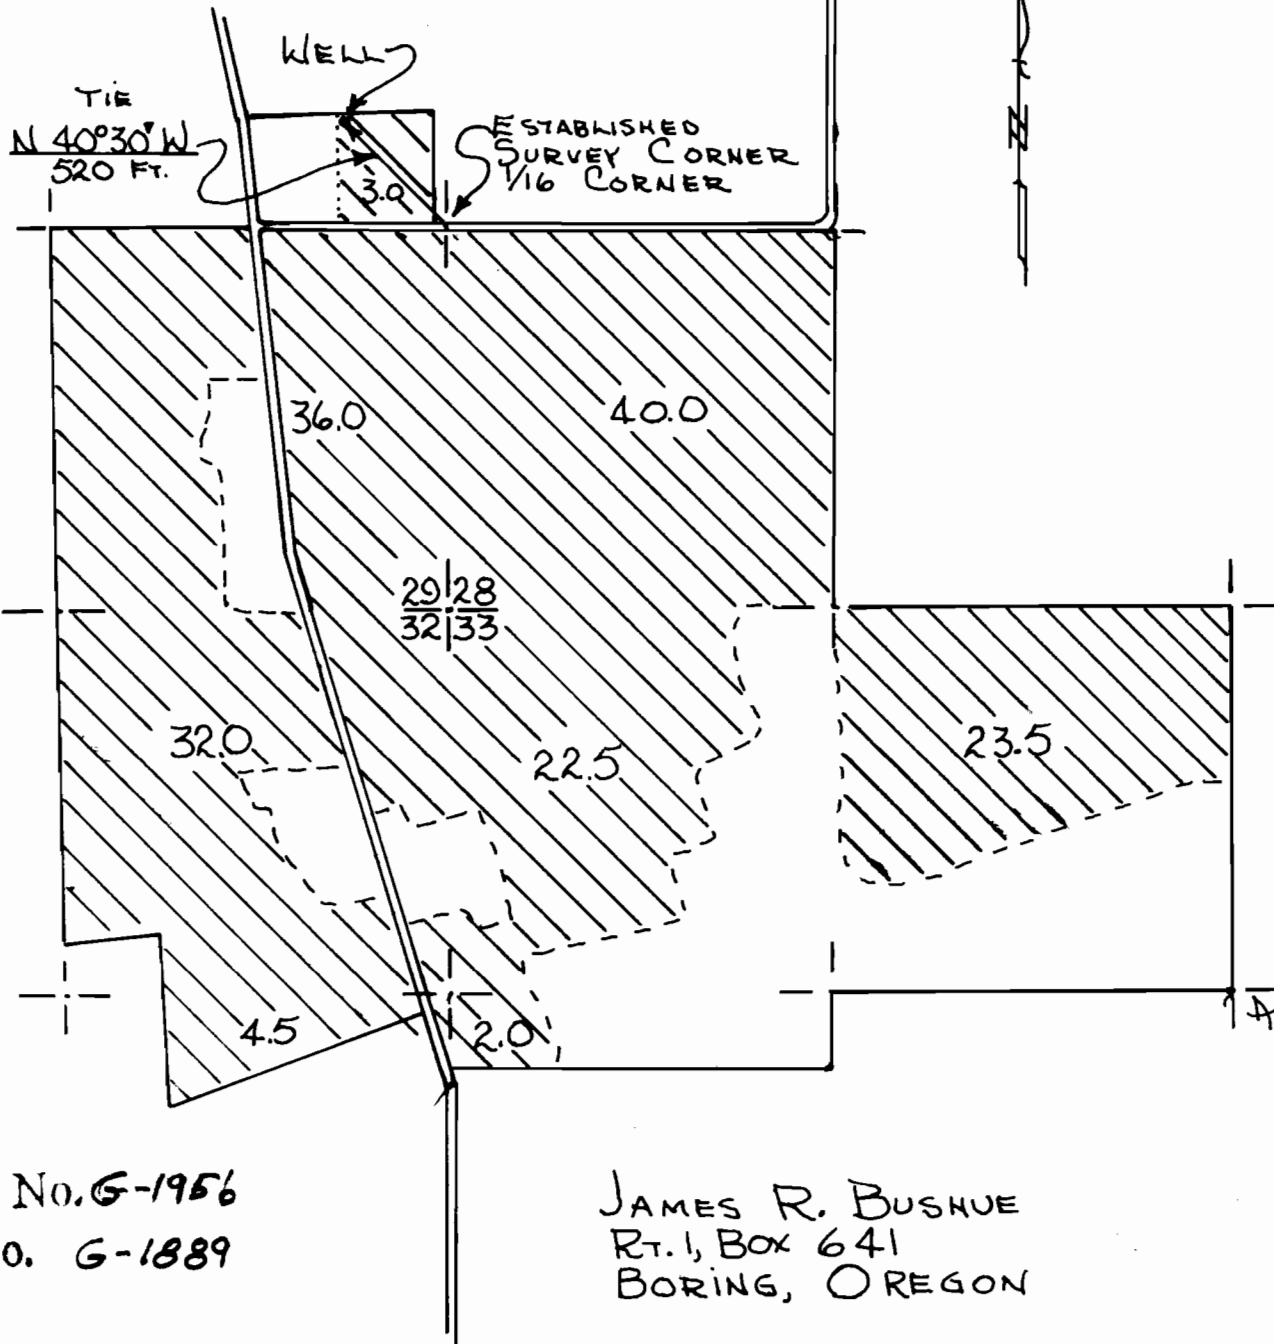

Application No. G-6107  
 Permit No. G 5784

Application No. G-1956  
 Permit No. G-1889

JAMES R. BUSHUE  
 RT. 1, BOX 641  
 BORING, OREGON